

KANSAS

Haskell

Section 14 Township 27 Range 34W

Well No. 1 Oliver


Company Cities Service

Hugoton

NORTH

WEST

EAST

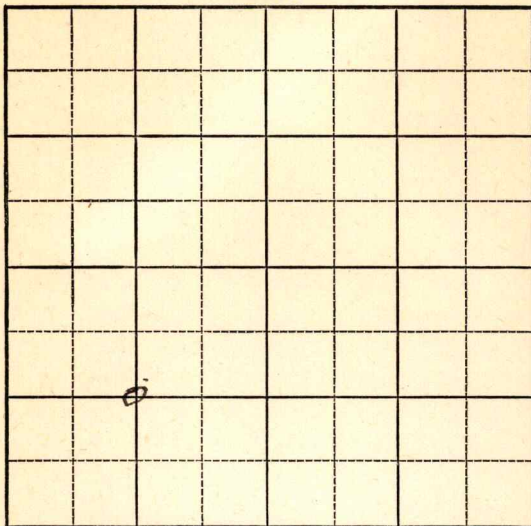

SOUTH

KANSAS

Haskell

✓
34W

Sec. 14 Twp. 27 R.

Well No. #1 Oliver Farm

Cities Service

Hugoton Pool (Lohman & Johnson, Cont.) Company


1320' Ft. from N. Line

Ft. from S. Line

Ft. from E. Line

1320' Ft. from W. Line

C SW

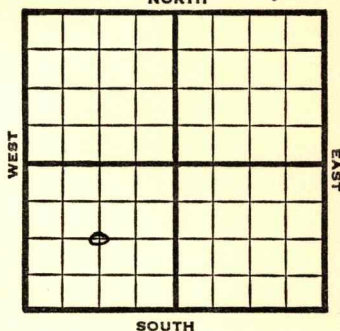

1949 **Elev 2991'** REPORT

5/25 Location

6/1 8" @ 800'
Drlg. 2180'

6/7 TD 2770'-
5" @ 2769'
160 shots 2666-98'
90 shots 2620-38
160 shots 2564-96'
40 shots 2530-38'

6/15 Acid 33,000

6/21 "

6/29 TD 2770'
5" @ 2769'
Perf
33000 acid
20,100,000 Gas
414# R Pr.
Comp

COMPLETED

Map No. _____ Sec. 14 Twp. 27 R. 34W

Well No. 1 Oliver

Cities Service Company

Lohman & Johnson Contractor

C SW


**FIRST REPORT
SECTION PLAT**

1320 Ft. from N. Line

_____ Ft. from S. Line

_____ Ft. from E. Line

1320 Ft. from W. Line

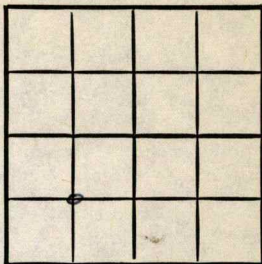

Haskell County

Location X

Rig up _____

Drilling and Remarks:

RECORD

Cased _____ in., _____ ft.

Sand _____

Gas _____

Oil _____

Total Depth _____

PRODUCTION

1st 24 hrs. Nat. _____

1st 24 hrs. after shot _____

Gas _____ Cu. Ft.

Dry Hole _____

Abandoned _____

Date

MAY 25 1949

19

S. J. LEWIS

Scout

Map No. ✓ Sec. 14 Twp. 27 R. 34W

Well No. 1 Oliver

Cities Service

Company

COMPLETE

Contractor

C SW

E. 2891
SECTION PLAT


1320 Ft. from N. Line

_____ Ft. from S. Line

_____ Ft. from E. Line

1320

_____ Ft. from W. Line

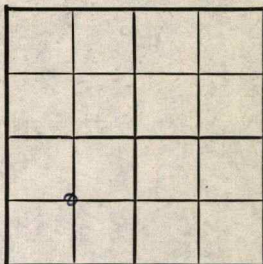

Haskell County

Location _____

Rig up _____

Drilling and Remarks:

5' 02769

Perf

33000 acid

20,100,000 Gas

414 R/P*

RECORD

Cased _____ in., _____ ft.

Sand _____

Gas _____

Oil _____

Total Depth 2770

PRODUCTION

1st 24 hrs. Nat. _____

1st 24 hrs. after shot _____

Gas _____ Cu. Ft.

Dry Hole _____

Abandoned _____

Date

JUN 29 1949 19

S. J. LEWIS Scout