

KANSAS


Haskell

Section 16 Township 27 Range 34W

Well No. 15 Jones

Company White Eagle

Hugoton
NORTH

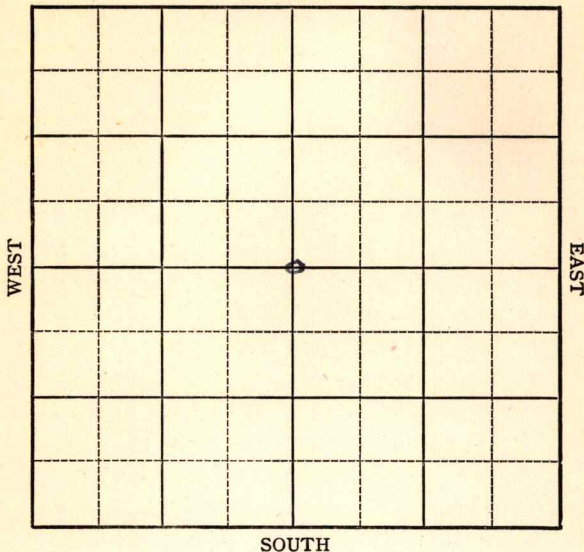

Sec. 16 Twp. 27 R. 34W ✓

Well No. #15 Jones Farm

White Eagle Company

Hugoton Pool (Burris, Cont.) NORTH


2640' Ft. from N. Line

 Ft. from S. Line

2640' Ft. from E. Line

 Ft. from W. Line

C Sec.

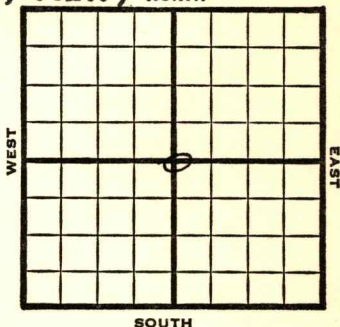

1949

Elev 2985'

R E P O R T

7/13

10" @ 539'

7" @ 2520'

TD 2535'

"

7/20

7/27

TD 2720'

8/3

189' of 5" Perf liner @ 2720
Acid 19,000

8/10

TD 2720'

7"@ 2520'

189' of 5" Perf Liner @ 2720'

19,000 acid

16,576,000 Gas

505# R Pr.

Comp

COMPLETED

Map No. 1 Sec. 16 Twp. 27 R. 34^W

Well No. 15 Jones

White Eagle Company

Burris Contractor

C Sec.


FIRST REPORT
SECTION PLAT

2640 Ft. from N. Line

 Ft. from S. Line

2640 Ft. from E. Line

 Ft. from W. Line

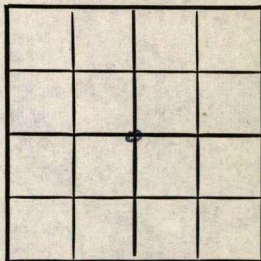

Haskell County

Location

Rig up

Drilling and Remarks:

10" @ 539

7" @ 2520

TD 2535

RECORD

Cased in., ft.

Sand

Gas

Oil

Total Depth

PRODUCTION

1st 24 hrs. Nat.

1st 24 hrs. after shot

Gas Cu. Ft.

Dry Hole

Abandoned

Date

JUL 13 1949 19

S. J. LEWIS Scout


Map No. ✓ Sec. 16 Twp. 27 R. 34WWell No. 15 JonesWhite Eagle

Company

COMPLETE

Contractor

C Sec.

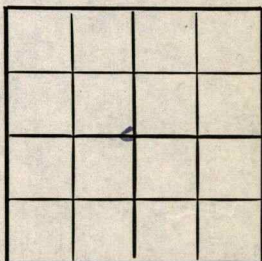E. 1, 2983
SECTION PLAT2640 Ft. from N. Line Ft. from S. Line2640 Ft. from E. Line Ft. from W. LineHaskell County**RECORD**Location Cased in., ft.Rig up Sand

Drilling and Remarks:

Gas *7" C2520*Oil Total Depth 2720*189' x 5" Perf line**C 2720**19000000**14,576,000 Gas***PRODUCTION**1st 24 hrs. Nat. 1st 24 hrs. after shot Gas Cu. Ft.Dry Hole Abandoned

Date

AUG 10 194919S. J. LEWISScout