


Section 23 Township 27 Range 3 4-W

Well No. #1 Brinkman

Company Cities Service

**Hugoton Pool** NORTH

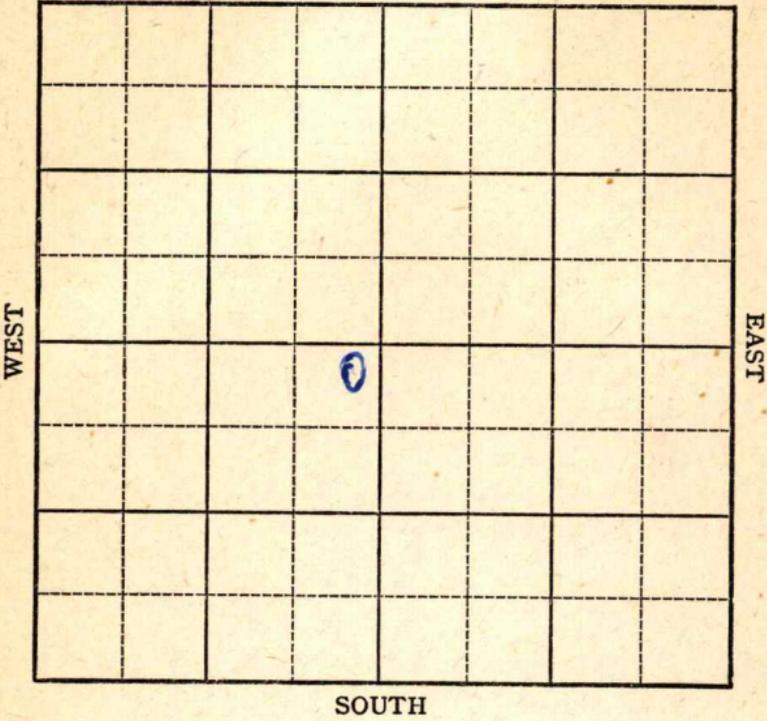

Sec. 23 Twp. 27 R. 34-W


Well No. 1 Brinkman Farm

Cities Service Company

Hugoton Pool

NORTH

100 Ft. from N. Line

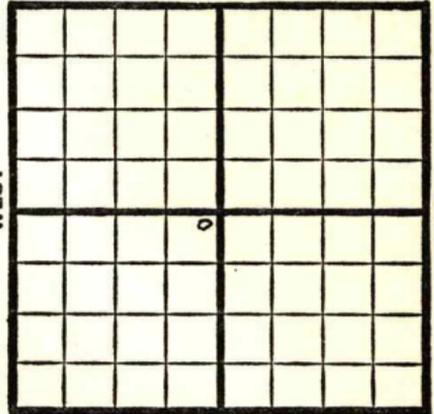

\_\_\_\_\_ Ft. from S. Line

100 Ft. from E. Line

\_\_\_\_\_ Ft. from W. Line

NE SW

SOUTH

1947

Elev. 3001' REPORT

8/20

Loc.

8/27

"

9/3

"

9/10

8" @ 784'

9/17

2589' fishing.

9/24

Skid rig 20' North  
8" @ 778'  
Drlg. 1290'

10/1

5" @ 2824'  
TD 2825'

10/8

140 shots 2738-46  
1000 acid

10/15

80 shots 2706-22  
40 " 2688-98  
80 " 2644-60  
105 " 2596-2617  
30 " 2582-88

24,000 Acid

10/22

9,000 acid

10/29

"

11/12

5" @ 2824'  
Perf.  
34,000 Acid  
17,000,000 Gas

Rock Pressure 400#  
Total Depth 2825'

COMPLETED

Map No. \_\_\_\_\_ Sec. 23 Twp. 27 R. 34W

Well No. 1 Brinkman

Cities Service Company

FIRST REPORT Contractor

NE SW

SECTION PLAT

100 Ft. from N. Line

\_\_\_\_\_ Ft. from S. Line

100 Ft. from E. Line

\_\_\_\_\_ Ft. from W. Line

	o		

Haskell County

Location X

Rig up \_\_\_\_\_

Drilling and Remarks:

RECORD

Cased \_\_\_\_\_ in., \_\_\_\_\_ ft.

Sand \_\_\_\_\_

Gas \_\_\_\_\_

Oil \_\_\_\_\_

Total Depth \_\_\_\_\_

PRODUCTION

1st 24 hrs. Nat. \_\_\_\_\_

1st 24 hrs. after shot \_\_\_\_\_

Gas \_\_\_\_\_ Cu. Ft.

Dry Hole \_\_\_\_\_

Abandoned \_\_\_\_\_

Date

AUG 20 1947

19

S. J. LEWIS

Scout

Kansas

Map No. ✓ Sec. 23 Twp. 27 R. 34W

Well No. 1 Brinkman

Cities Service Company

COMPLETE Contractor

NE SW


*E1.3001*  
SECTION PLAT

100 Ft. from N. Line

         Ft. from S. Line

100 Ft. from E. Line

         Ft. from W. Line

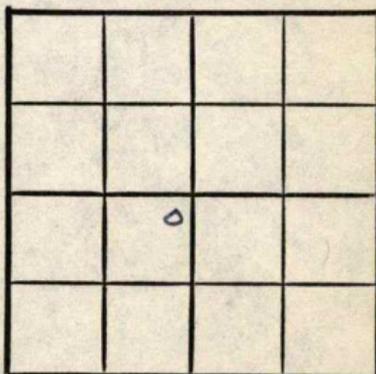

Haskell County

Location                                 

Rig up                                 

Drilling and Remarks:

*5062824*  
*Perf*  
*345000000*  
*17N Gas*

*400 # RB*

RECORD

Cased                  in.,                  ft.

Sand                                 

Gas                                 

Oil                                 

Total Depth 2825

PRODUCTION

1st 24 hrs. Nat.                                 

1st 24 hrs. after shot                                 

Gas                                  Cu. Ft.

Dry Hole                                 

Abandoned                                 

Date

NOV 12 1947 19

S. I. LEWIS Scout