


Section 27- Township 27 Range 34W

Well No. 1 Alexander "C"

Company Cities Service

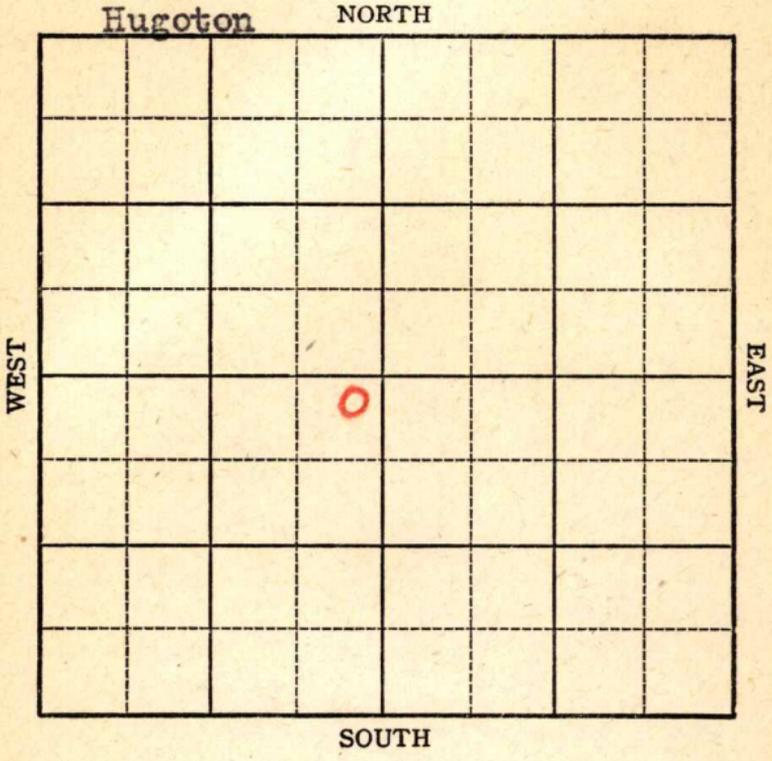

Sec. 27 Twp. 27 R. 34W

Well No. #1 Alexander "C" Farm

Cities Service Company

Hugoton


100 Ft. from N. Line

_____ Ft. from S. Line

100 Ft. from E. Line

_____ Ft. from W. Line

NE SW

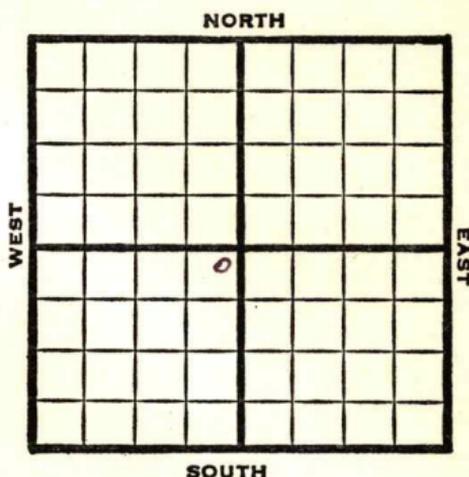

1947 **Elev. 3038!** REPORT

8/6	Location
8/13	RUR
8/20	8" @ 800' Drlg 2584'
8/27	TD 2855' 5" @ 2854' RUST
9/3	60 shots 2788-2800 30 " 2768-74 - 1000 Acid
9/10	30 shots 2768-74 - 1000 Acid 89 " 2722-40 - 1150 " 96 " 2678-98 - 1350 " 50 " 2658-68 - 500 " 13000 Acid
9/17	" "
9/24	" "
10/1	" "
10/8	" "
10/15	" "

OVER

1947

10/22

5" @ 2854'

Perf

20,000 Acid

6,140,000 Gas

Rock Pressure 387#

Total Depth 2855'

COMPLETED

Map No. _____ Sec. 27 Twp. 27 R. 34W

Well No. 1 Alexander "C"

Cities Service

Company

FIRST REPORT

Contractor

NE SW


SECTION PLAT

100 Ft. from N. Line

_____ Ft. from S. Line

100 Ft. from E. Line

_____ Ft. from W. Line

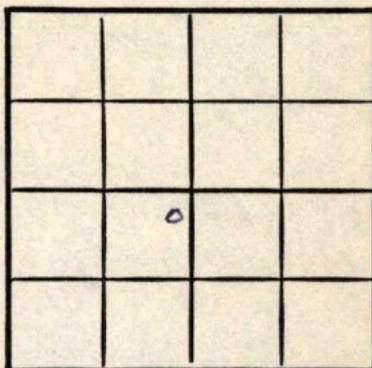

Haskell County

Location X

Rig up _____

Drilling and Remarks:

RECORD

Cased _____ in., _____ ft.

Sand _____

Gas _____

Oil _____

Total Depth _____

PRODUCTION

1st 24 hrs. Nat. _____

1st 24 hrs. after shot _____

Gas _____ Cu. Ft.

Dry Hole _____

Abandoned _____

Date

AUG 6 1947 19

S. J. LEWIS

Scout

Kansas Hugoton Pool

Map No. 0 Sec. 27 Twp. 27 R. 34W

Well No. 1 Alexander "C"

Cities Service Company

COMPLETE Contractor

NE SW

E. 3038
SECTION PLAT

100 Ft. from N. Line

_____ Ft. from S. Line

100 Ft. from E. Line

_____ Ft. from W. Line

	0		

Haskell County

Location _____

Rig up _____

Drilling and Remarks:

5' @ 2554

Prod

2600000 cu ft

6,140,000 Gas

*382 * R*

RECORD

Cased _____ in., _____ ft.

Sand _____

Gas _____

Oil _____

Total Depth 2835

PRODUCTION

1st 24 hrs. Nat. _____

1st 24 hrs. after shot _____

Gas _____ Cu. Ft.

Dry Hole _____

Abandoned _____

Date

OCT 22 1947

19

S. J. LEWIS

Scout