


Section 18 Township 27 Range 34-W

Well No. #7 Jones

Company Helmerich & Payne

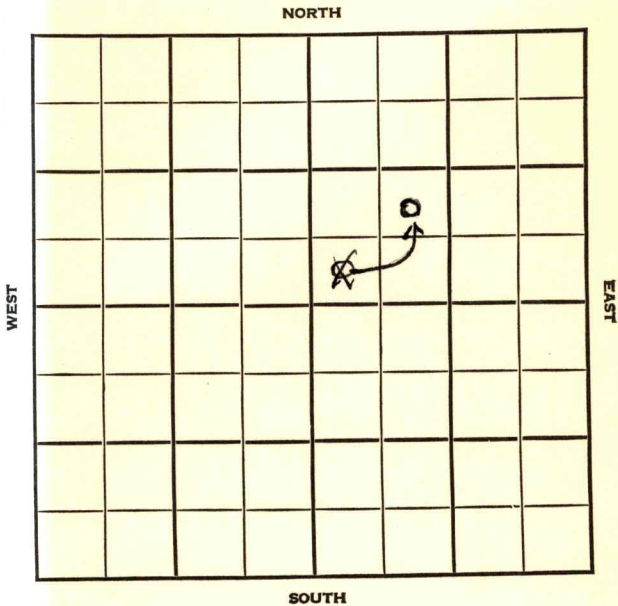

KANSAS

Haskell

Sec. 18 Twp. 27 R. 34W

Well No. #7 Jones Farm

Helmerich & Payne Company

Hugoton Pool

Ft. from N. Line


990'
300'

Ft. from S. Line

Ft. from E. Line

990'
300'

Ft. from W. Line

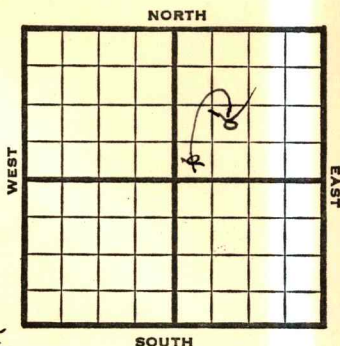

SW NE NE SW NE

1948

Elev. 3004' REPORT

5/5 10" @ 540'
Drlg. 2400'

5/12 TD 2585'
7" @ 2570'

5/19 TD 2720'

5/26 "

6/1 "

6/9 15,000 Acid

6/16 "

6/23 "

6/29 "

7/8 "

7/14 "

7/21 "

7/28 "

8/4 "

8/11 "

8/18 "

8/25 "

9/1 "

9/8 "

9/14 "

9/21 "

9/29 "

OVER

1948

10/6	1500 acid
10/13	"
10/19	"
10/26	"
11/3	"
11/10	"
11/16	"
11/23	"
11/30	"
12/6	"
12/14	"
12/22	"
12/29	"
1/5	#
1/12	"
1/19	"
1/26	"
2/2	"
2/9	1500 acid
2/16	6000 acid
2/23	102 qts 2594-2632 120 qts 2680-2714 CO
3/2	10,000 acid
3/8	145' of 5" Perf Liner @ 2720'
3/16	"
3/23	7" @ 2570' 145' of 5" Perf liner @ 2720' Acid 31,000 Gas 10,771,000 gas RPr. 400# TD 2720'

COMPLETED

Map No. _____ Sec. 18 Twp. 27 R. 34W

Well No. 7 Jones

Helmerich & Payne Company

FIRST REPORT Contractor

SW NE

SECTION PLAT

_____ Ft. from N. Line

300 Ft. from S. Line

_____ Ft. from E. Line

300 Ft. from W. Line

Haskell County

Location _____

Rig up _____

Drilling and Remarks:

10" @ 540

drlg. 2400

RECORD

Cased _____ in., _____ ft.

Sand _____

Gas _____

Oil _____

Total Depth _____

PRODUCTION

1st 24 hrs. Nat. _____

1st 24 hrs. after shot _____

Gas _____ Cu. Ft.

Dry Hole _____

Abandoned _____

Date

MAY 5 1948 19 S. J. LEWIS Scout

Map No. _____ Sec. 18 Twp. 27 R. 34W

Well No. 7 Jones

Helmerich & Payne Company

CORRECTION

Contractor

NE SW NE

SECTION PLAT

		o	

_____ Ft. from N. Line

990 Ft. from S. Line

_____ Ft. from E. Line

990 Ft. from W. Line

Haskell County

Location _____

Rig up _____

Drilling and Remarks:

Reported

SW NE

RECORD

Cased _____ in., _____ ft.

Sand _____

Gas _____

Oil _____

Total Depth _____

PRODUCTION

1st 24 hrs. Nat. _____

1st 24 hrs. after shot _____

Gas _____ Cu. Ft.

Dry Hole _____

Abandoned _____

Date

MAY 26 1948 19 S. J. LEWIS Scout

Kansas

Map No. _____ Sec. 18 Twp. 27 R. 34W

Well No. 7 Jones

Helmerich & Payne Company
CORRECTION

Contractor

NE SW NE

SECTION PLAT

		o	

_____ Ft. from N. Line

990 Ft. from S. Line

_____ Ft. from E. Line

990 Ft. from W. Line

Haskell County

Location _____

Rig up _____

Drilling and Remarks:

Reported SW SE

RECORD

Cased _____ in., _____ ft.

Sand _____

Gas _____

Oil _____

Total Depth _____

PRODUCTION

1st 24 hrs. Nat. _____

1st 24 hrs. after shot _____

Gas _____ Cu. Ft.

Dry Hole _____

Abandoned _____

Date

MAR 30 1949 19

S. J. LEWIS Scout


Map No. _____ Sec. 18 Twp. 27 R. 34WWell No. 7 JonesHelmerich & Payne

Company

COMPLETE

Contractor

NE SW NE

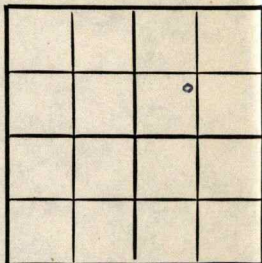E 1,300 4
SECTION PLAT

_____ Ft. from N. Line

990

_____ Ft. from S. Line

_____ Ft. from E. Line

990

_____ Ft. from W. Line

Haskell County**RECORD**

Location _____

Cased _____ in., _____ ft.

Rig up _____

Sand _____

Drilling and Remarks:

Gas _____

7" @ 2570

Oil _____

*145' of 5" Prof line*Total Depth 2720*@ 2720**81000 acid**10, 771, 000 Gas***PRODUCTION**

1st 24 hrs. Nat. _____

1st 24 hrs. after shot _____

Gas _____ Cu. Ft.

Dry Hole _____

Abandoned _____

400# R/B

Date

MAR 23 1949 19S. J. LEWIS Scout

check spot
1st report shows

SW NE

address

San

Don't have map on this
location

Scout Cards _____
Land Small Map _____
Land Wall Map _____
Tracings _____
France Map _____
Pierce Map _____
Misc. _____