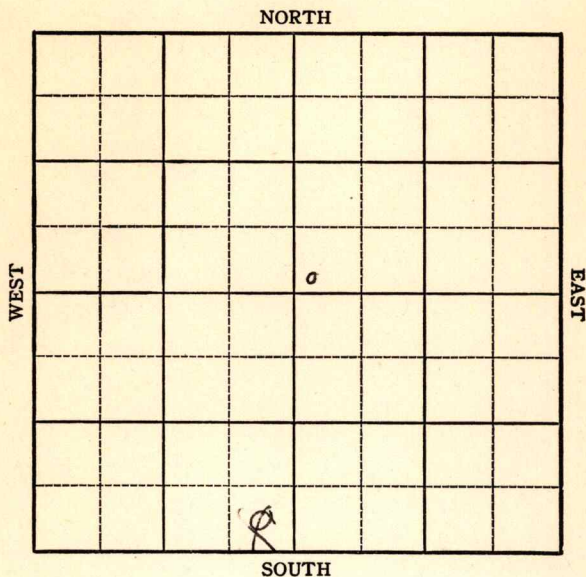


KANSAS

Haskell

Section 21 Township 27 Range 34WWell No. 1 LewisCompany Columbian

KANSAS Haskell

Sec. 21 Twp. 27 R. 34W ✓

Well No. #1 Lewis Farm

Columbian Fuel Company


Hugoton Pool

 Ft. from N. Line

100' Ft. from S. Line

 Ft. from E. Line

100' Ft. from W. Line

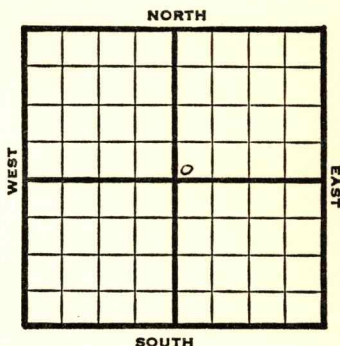

SW NE

1949

Elev 3022'

R E P O R T

3/2	Location
3/8	"
3/16	"
3/23	"
3/30	"
4/6	"
4/12	10" @ 600'
4/20	TD 2635'
	7" @ 2623'
4/27	Drilg. 2723'
5/4	TD 2810'
5/10	15000 acid
5/18	TD 2810'
	7" @ 2623'
	194' of 5" Perf liner @ 2810'
	15000 acid
	21,968,000 Gas
	424# R Pr.
	Comp

COMPLETED

Map No. _____ Sec. 21 Twp. 27 R. 34W

Well No. 1 Lewis

Columbian Fuel Company

FIRST REPORT Contractor

SW NE


SECTION PLAT

_____ Ft. from N. Line

100 Ft. from S. Line

_____ Ft. from E. Line

100 Ft. from W. Line

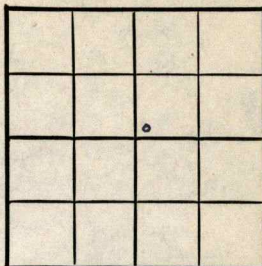

Haskell County

Location X

Rig up _____

Drilling and Remarks:

RECORD

Cased _____ in., _____ ft.

Sand _____

Gas _____

Oil _____

Total Depth _____

PRODUCTION

1st 24 hrs. Nat. _____

1st 24 hrs. after shot _____

Gas _____ Cu. Ft.

Dry Hole _____

Abandoned _____

Date

MAR 2 1949 19

S. J. LEWIS Scout

Map No. _____ Sec. 21 Twp. 27 R. 34W

Well No. 1 Lewis

Columbian Fuel Company

COMPLETE Contractor

SW NE

E 1, 3022


SECTION PLAT

_____ Ft. from N. Line

100 Ft. from S. Line

_____ Ft. from E. Line

100 Ft. from W. Line

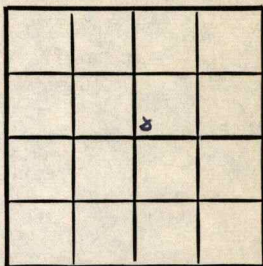

Haskell County

Location _____

Rig up _____

Drilling and Remarks:

7" @ 2625

194' 2 1/2" Perforated

@ 2710

15000 acid

21, 968,000 gal

424# R/A

RECORD

Cased _____ in., _____ ft.

Sand _____

Gas _____

Oil _____

Total Depth 2870

PRODUCTION

1st 24 hrs. Nat. _____

1st 24 hrs. after shot _____

Gas _____ Cu. Ft.

Dry Hole _____

Abandoned _____

Date

MAY 18 1949

19

S. J. LEWIS

Scout