

KANSAS


Haskell

Section 20 Township 27 Range 34W

Well No. 1 Tunis

Company Columbian Fuel

Hugoton
NORTH

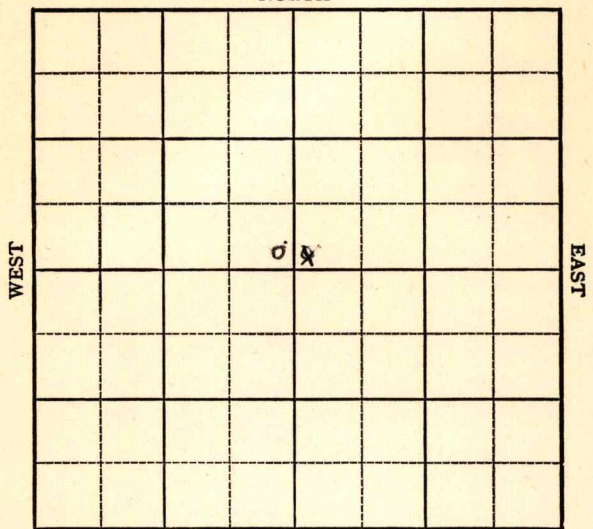

SOUTH

KANSAS

Haskell

✓

Sec. 20 Twp. 27 R. 34W

Well No. #1 Tunis Farm

Columbian Fuel Company


Hugoton Pool

 Ft. from N. Line

100' Ft. from S. Line

100' Ft. from E. Line

 Ft. from W. Line

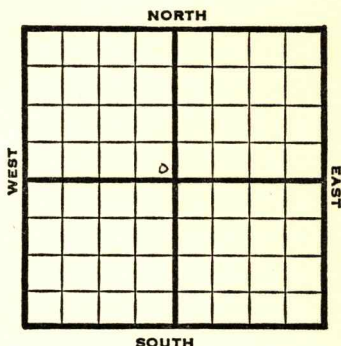

SE NW

1949

Elev 3020'

R E P O R T

3/2 Location

3/8 "

3/16 "

3/23 "

3/30 RUR

4/6 10" @ 600'

Drlg. 1440'

4/12 TD 2660'

7" @ 2594'

4/20 "

4/27 TD 2778'

194' of 5" Perf liner @ 2778'

1500 acid

5/4 TD 2778'

7" @ 2594'

194' of 5" Perf Liner @ 2778'

1500 acid

8,260,000 Gas

428# R Pr.

Comp

COMPLETED

Map No. _____ Sec. 20 Twp. 27 R. 34W

Well No. 1 Tunis

Columbian Fuel Company

FIRST REPORT

Contractor _____

SE NW


SECTION PLAT

_____ Ft. from N. Line

100 Ft. from S. Line

100 Ft. from E. Line

_____ Ft. from W. Line

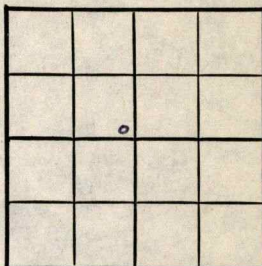

Haskell County

Location X

Rig up _____

Drilling and Remarks:

RECORD

Cased _____ in., _____ ft.

Sand _____

Gas _____

Oil _____

Total Depth _____

PRODUCTION

1st 24 hrs. Nat. _____

1st 24 hrs. after shot _____

Gas _____ Cu. Ft.

Dry Hole _____

Abandoned _____

Date

MAR 2 1949 19

S. J. LEWIS

Scout

