

KANSAS

Haskell

Section 2 Township 27 Range 34W

Well No. 1 Gunnell

Company White Eagle

Hugoton

NORTH

WEST								EAST

SOUTH

0

Haskell **KANSAS**

Sec. 2 Twp. 27 R. 34W ✓

Well No. #1 Gunnell Farm _____

White Eagle Company _____

Hugoton Pool (Burris, Cont.)

NORTH

_____ Ft. from N. Line


330'

_____ Ft. from S. Line

_____ Ft. from E. Line

330'

_____ Ft. from W. Line

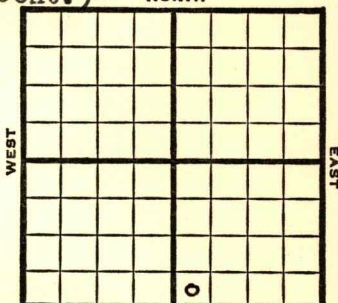

SOUTH

SW SE

1949

Elev 2965'

R E P O R T

7/13 Location

7/20 "

7/27 10" @ 545'

8/3 TD 2610'

7" @ 2593'

8/10 "

8/17 Drlg. 2625'

8/24 TD 2766-185' of 5" Perf liner @2766
13000 acid

8/31 TD 2766'

7" @ 2593'

185' of 5" Perf Liner @ 2766'

15000 acid

11,092,000 Gas

420# R Pr.

Comp

COMPLETED

Map No. _____ Sec. 2 Twp. 27 R. 34W

Well No. 1 Gunnell

White Eagle Company

Burris Contractor

SW SE

**FIRST REPORT
SECTION PLAT**

_____ Ft. from N. Line

330 Ft. from S. Line

_____ Ft. from E. Line

330 Ft. from W. Line

Haskell County

Location X

Rig up _____

Drilling and Remarks:

RECORD

Cased _____ in., _____ ft.

Sand _____

Gas _____

Oil _____

Total Depth _____

PRODUCTION

1st 24 hrs. Nat. _____

1st 24 hrs. after shot _____

Gas _____ Cu. Ft.

Dry Hole _____

Abandoned _____

Date

JUL 13 1949 19 S. J. LEWIS Scout

Map No. Sec. 2 Twp. 27 R. 34W

Well No. 1 Gunnell

White Eagle Company

COMPLETE

Contractor

SW SE

E1-2965

SECTION PLAT

 Ft. from N. Line

330 Ft. from S. Line

 Ft. from E. Line

330 Ft. from W. Line

Haskell County

RECORD

Location

Cased in., ft.

Rig up

Sand

Drilling and Remarks:

Gas

Oil

Total Depth 2766

PRODUCTION

1st 24 hrs. Nat.

1st 24 hrs. after shot

Gas Cu. Ft.

Dry Hole

Abandoned

Date

AUG 31 1949

19

S. J. LEWIS

Scout