


Haskell

SECTION 4 TOWNSHIP 27 RANGE 34W

WELL NO. #4-~~10~~ Devlin-Jones

COMPANY Helmerich & Payne

NORTH

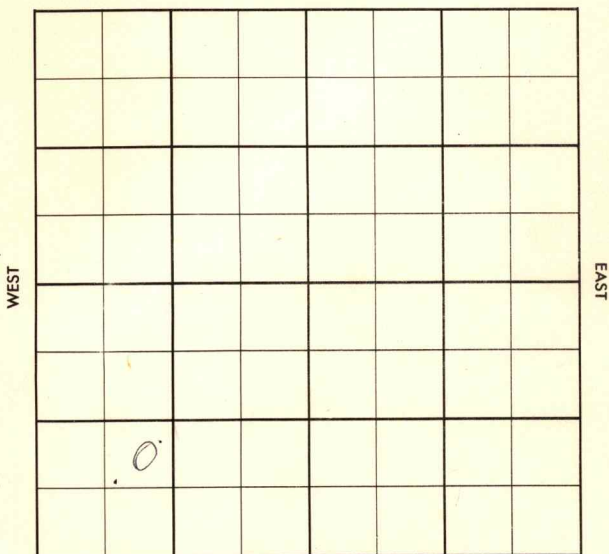

SOUTH

County Haskell Elev. _____
 Sec. 4 Twp. 27 Rge. 34W
 Company Helmerich & Payne
 Farm Name Devlin-Jones No. 4-10

TOPS	DEPTH	LOG	DATUM	Loc. in Sec.
Anh.				NE SW SW
Tr.				
H.				
Tr.				
Dg.				
Bl.				
L.				Geol.
K.C.				Contr.
B.K.C.				Co. Tools
Ce.				
C.				Pool
M.				Pleasant Pr
M.				
K.				
Mz.				
Me.				
V.				
S.				
S.				
A				
R.				
Pe.				
G.				
T.D.				

Date Comm. 12-22-56

Drlg. 835, running surface



no.

Sec.

T.

R.

~~35~~

County Haskell Elev. 2283
 Sec. 4 Twp. 27 Rge. 34W
 Company Helmerich & Payne
 Farm Name Devlin-Jones No. 4-10

TOPS	DEPTH	LOG	DATUM	Loc. in Sec.
Anh.				NE SW SW
Tp.		3446		
H.		3880		
Tr.		3890		
Dg.				
Bl.				
L.		3921		Geol.
K.C.				Contr.
B.K.C. <u>Marm</u>		4522		Co. Tools
Ce.		4664		
C. <u>Atoka</u>		4870		
M.	5005			Pool
M.				Pleasant Fair.
K. <u>Mush</u>		4928		
Mz. <u>St Gen</u>		5004		
Mo. <u>St Louis</u>		5050		
V.				
S.				
S.				
A.				
R.				
Pe.				
G.				
TD	5188			

FEB 20 '57	
COMPLETE	

Date Comm. 12-22-56

Drlg. 835, running surface JAN 2 '57

ID 2758 10 3/4 @ 785

/550 ID 3845 4795

JAN 23 '57 cld 5007-57 rec 50'

cld 5081-5106 rec 26' cld 5146

-57 rec 50' ID 5182 JAN 30 '57

5 1/2 @ 5187 co 5149 40/5110-20

40/5006-16 12 1/2 @ 5187 & 20 Frac

20x18 & 16 Boph no/w 6 hrs

\$ 20 Boph 3 hrs POP FEB 13 '57

32/5051-59 (back PFS.) FEB 20 '57

P. 175 Bopd not wtr

Ch P. 151 Bopd not wtr

gran 34°