


KANSAS

Section 3 Township 27 Range 34W

Well No. #10 Jones

Company Helmerich & Payne

Hugoton

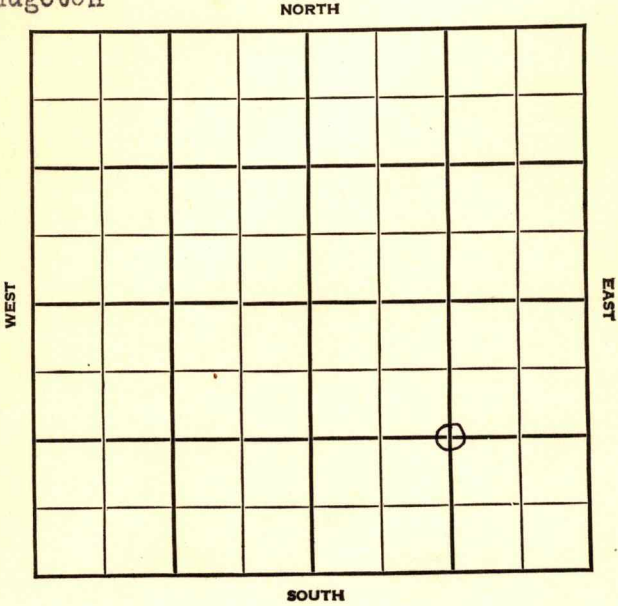



Sec. 3 Twp. 27 R. 34W

Well No. #10 Jones Farm _____

Helmerich & Payne Company

Hugoton Pool


1320' Ft. from N. Line

_____ Ft. from S. Line

1320' Ft. from E. Line

_____ Ft. from W. Line

C SE

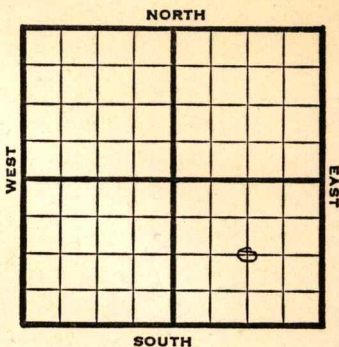

1948

Eli 2998'

REPORT

2/25

RUR

3/3

10" @ 568'
Drlg. 900'

3/10

TD 2611'
7" @ 2500' fsg.

3/17

"

3/24

PB 1352'

3/31

TD 2610'
7" @ 2600'
RUST

4/7

TD 2779'
12000 acid.

4/14

PB 2740'

4/21

"

4/28

"

5/5

"

5/12

"

5/19

194' of 5" Perf liner @ 2740'

5/26

"

6/1

"

6/9

TD 2779'

OVER

1948

6/16	TD 2779'
6/23	"
6/29	"
7/8	"
7/14	"
7/21	"
7/28	"
8/4	"
8/11	"
8/18	"
8/25	"
9/1	"
9/8	"
9/14	"
9/21	"

9/29 TD 2779'
7"@ 2600'
194' of 5" perf liner @ 2779'
12000 acid
606,000 gas
405# R Pr.
Comp

COMPLETED

Map No. _____ Sec. 3 Twp. 27 R. 34W

Well No. 10 Jones

Helmerich & Payne Company

FIRST REPORT

Contractor

C SE

SECTION PLAT

1320 Ft. from N. Line

_____ Ft. from S. Line

1320 Ft. from E. Line

_____ Ft. from W. Line

Haskell County

Location _____

Rig up _____

Drilling and Remarks:

R U R

RECORD

Cased _____ in., _____ ft.

Sand _____

Gas _____

Oil _____

Total Depth _____

PRODUCTION

1st 24 hrs. Nat. _____

1st 24 hrs. after shot _____

Gas _____ Cu. Ft.

Dry Hole _____

Abandoned _____

Date

FEB 25 1948 19_____

S. J. LEWIS Scout

Map No. _____ Sec. 3 Twp. 27 R. 34W

Well No. 10 Jones

Helmerich & Payne Company

COMPLETE

Contractor

C SE


E, 2995
SECTION PLAT

_____ Ft. from N. Line

1320 Ft. from S. Line

1320 Ft. from E. Line

_____ Ft. from W. Line

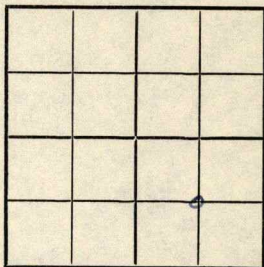

Haskell County

Location _____

Rig up _____

Drilling and Remarks:

7" @ 2600
194' of 5" Prof liner
@ 2779 / 2000 acid
606,000 Gas
*#05 * R/P*

RECORD

Cased _____ in., _____ ft.

Sand _____

Gas _____

Oil _____

Total Depth 2779

PRODUCTION

1st 24 hrs. Nat. _____

1st 24 hrs. after shot _____

Gas _____ Cu. Ft.

Dry Hole _____

Abandoned _____

Date

SEP 29 1948

19

S. J. LEWIS

Scout