

Haskell


KANSAS

FORM 51 IOM 12-46 PETROL

Section 4 Township 27 Range 34W

Well No. 9 Jones

Company Helmerich & Payne

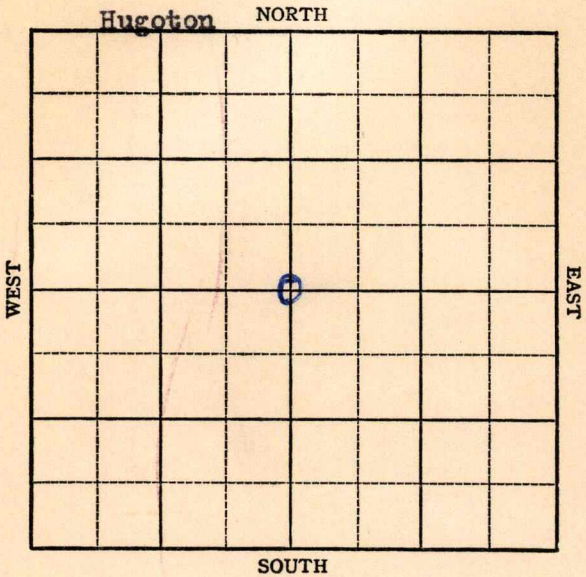

KANSAS


Sec. 4 Twp. 27 R. 34WWell No. #9 Jones FarmHelmerich & Payne Company2640 Hugoton
Ft. from N. Line

Ft. from S. Line

2640
Ft. from E. Line

Ft. from W. Line

C. Sec.

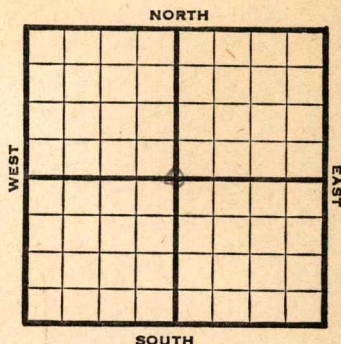

1947	Elev. -	REPORT
9/10		Drlg. 1500
9/17		10" @ 735' TD 2532' 7" @ 2523' RUST
9/24		TD 2532'
10/1		"
10/8		TD 2740' 1000 Acid
10/15		243' of 5" Perf Liner @ 2740' 14,000 acid
10/22		"
10/29		"
11/12		7" @ 2523' 243' of 5" Perf liner @ 2740' 25,000 acid Acid 25,000 982,000 Gas Rock Pressure 419# Total Depth 2740' COMPLETED

Map No. _____ Sec. 4 Twp. 27 R. 34W

Well No. 9 Jones

Helmerich & Payne Company

FIRST REPORT Contractor

C Sec.


SECTION PLAT

2640 Ft. from N. Line

_____ Ft. from S. Line

2640 Ft. from E. Line

_____ Ft. from W. Line

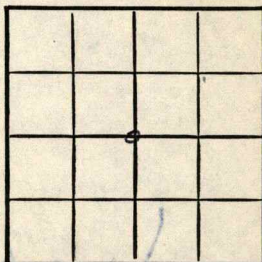

Haskell County

Location _____

Rig up _____

Drilling and Remarks:

drlg. 1500

RECORD

Cased _____ in., _____ ft.

Sand _____

Gas _____

Oil _____

Total Depth _____

PRODUCTION

1st 24 hrs. Nat. _____

1st 24 hrs. after shot _____

Gas _____ Cu. Ft.

Dry Hole _____

Abandoned _____

Date

SEP 10 1947 19 S. J. LEWIS Scout

