

KANSAS

Stanton

Section 34 Township 27 Range 39-WWell No. 1 KnoperCompany Stanolind

Hugoton Pool

NORTH

WEST

EAST

SOUTH

Sec. 34 Twp. 27 R. 39W

Well No. #1 Knoper Farm

Stanolind Company

Hugoton


 Ft. from N. Line

150 Ft. from S. Line

 Ft. from E. Line

150 Ft. from W. Line

SW NE

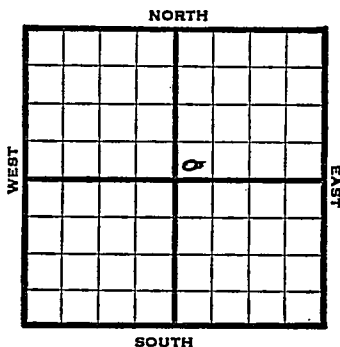

1947

Elev. 3155' REPORT

10/1

9" @ 655'
Drlg. 1433'

10/8

7" @ 2290'
TD 2300'

10/15

TD 2505'

10/22

7 " @ 2290'
228' of 5" Perf liner @ 2505'
17,000 Acid
8,175,000 Gas
Rock Pressure 420#
Total Depth 2505'

COMPLETED

Map No. _____ Sec. 34 Twp. 27 R. 39WWell No. 1 Knoper

Stanolind _____ Company

FIRST REPORT

Contractor _____

SW NE

SECTION PLAT

_____ Ft. from N. Line

150 Ft. from S. Line

_____ Ft. from E. Line

150 Ft. from W. Line

Stanton County

Location _____

Rig up _____

Drilling and Remarks:

9" @ 655

drlg. 1433

RECORD

Cased _____ in., _____ ft.

Sand _____

Gas _____

Oil _____

Total Depth _____

PRODUCTION

1st 24 hrs. Nat. _____

1st 24 hrs. after shot _____

Gas _____ Cu. Ft.

Dry Hole _____

Abandoned _____

Date

OCT 1 1947 19

S. J. LEWIS Scout

Hugoton Pool

Map No. 0 Sec. 34 Twp. 27 R. 39W

Well No. 1 Knoper

Stanolind Company

COMPLETE Contractor

SW NE


E1,8155
SECTION PLAT

 Ft. from N. Line

150 Ft. from S. Line

 Ft. from E. Line

150 Ft. from W. Line

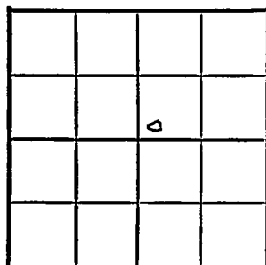

Stanton County

Location

Rig up

Drilling and Remarks:

7" @ 2290

228' of 5" Pay line

@ 2505'

17000 aced

8,175,000 lbs

420 # R/A

RECORD

Cased in., ft.

Sand

Gas

Oil

Total Depth 2505'

PRODUCTION

1st 24 hrs. Nat.

1st 24 hrs. after shot

Gas Cu. Ft.

Dry Hole

Abandoned

Date

OCT 22 1947 19

S. J. LEWIS Scout