

KANSAS


FORM 51 5M 1-42 PETROL

Pratt

Section 34 Township 27 Range 11-W

Well No. #3 Fitzsimmons

Company Drillers Gas

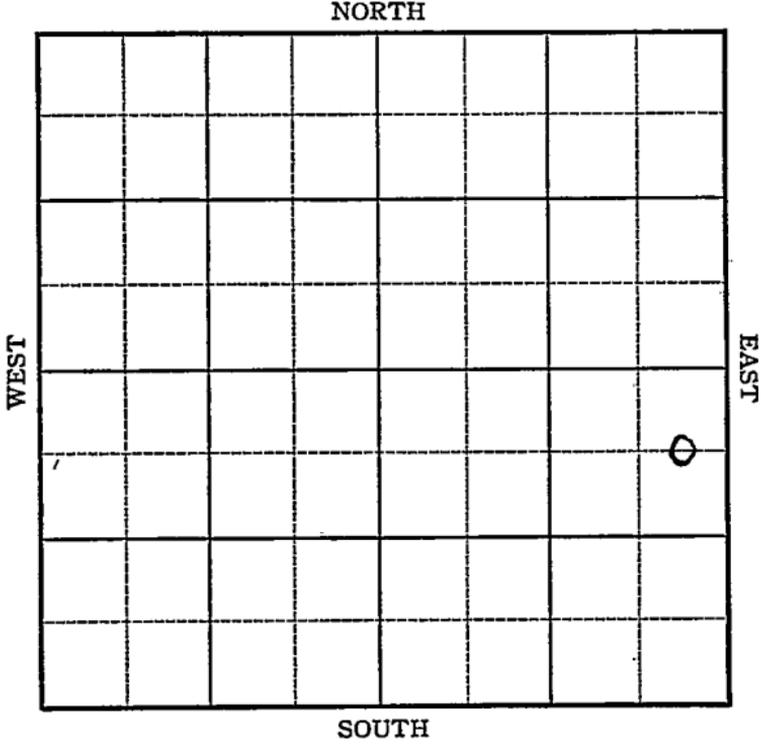

Sec. 34 Twp. 27 R. 11-W

Well No. #3 Fitzsimmons Farm

Drillers Gas Company


660 Ft. from N. Line

_____ Ft. from S. Line

330 Ft. from E. Line

_____ Ft. from W. Line

Edw. 1712

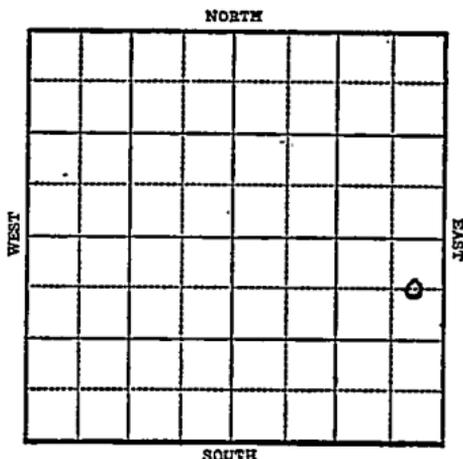

1943

R E P O R T

5/5 Surface Hole.

5/12 10" @ 316'

Drlg. 2300'

5/19 Lans 3485

T.D. 3622 SO

5" @ 3618 Rust

" " "

5/26

6/2 46 shots 3482-3516
225' oil in 16 hrs.

6/9 4000 acid

6/16

Lans 3485

5" @ 3618'

T.D. 3622'

40 shots 3498-3516

6 shots 3482-85

4000 gal acid

Pump 605 Pot

Gravity 41

COMPLETED

Pratt

Map No. KANSAS Sec. 34 Twp. 27 R. 11W

Well No. 3 Fitzsimmons

Drillers Gas Company

FIRST REPORT Contractor

C EL NE SE

SECTION PLAT

660 Ft. from N. Line

_____ Ft. from S. Line

330 Ft. from E. Line

_____ Ft. from W. Line

			o
		.	

CUNNINGHAM POOL

Location _____

Rig up _____

Drilling and Remarks:

Surface Hole

RECORD

Cased _____ in., _____ ft.

Sand _____

Gas _____

Oil _____

Total Depth _____

PRODUCTION

1st 24 hrs. Nat. _____

1st 24 hrs. after shot _____

Gas _____ Cu. Ft.


Dry Hole _____

Abandoned _____

Date

MAY 5 1943 19

S. J. LEWIS Scout

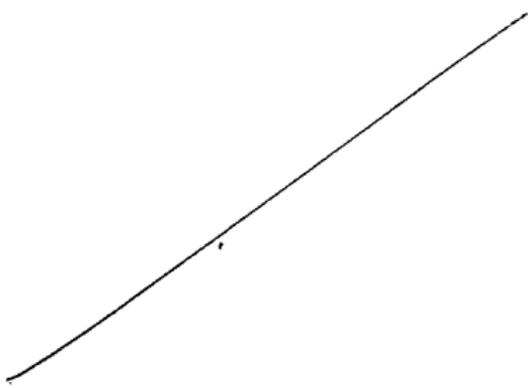

Misc Small Maps	<i>Qua</i>
Cards	<i>Qua</i>
Tracing	<i>MB</i>
France Map	<i>[initials]</i>
Scarborough Map	<i>[initials]</i>
Moody Map	<i>[initials]</i>
Geological Dept.	
Moody Flat Book	

KANSAS

Pratt

Map No. 54 Sec. 34 Twp. 27 R. 11WWell No. 3 Fitzsimmons

Drillers Gas

Company

COMPLETED

Contractor

C E L N E S E

SECTION PLAT

660 Ft. from N. Line

Ft. from S. Line

330 Ft. from E. Line

Ft. from W. Line

			0

CUNNINGHAM POOL

Location _____

Rig up _____

Drilling and Remarks:

Loc 3485
5" C 3618
70 hrs to 3498-3516
6 " 3482-85
4000 acid
Pump 605 P24
410 Gr

RECORD

Cased _____ in., _____ ft.

Sand _____

Gas _____

Oil _____

Total Depth 3622

PRODUCTION

1st 24 hrs. Nat. _____

1st 24 hrs. after shot _____

Gas _____ Cu. Ft.


Dry Hole _____

Abandoned _____

Date

JUN 16 1943 19

S. J. LEWIS Scout

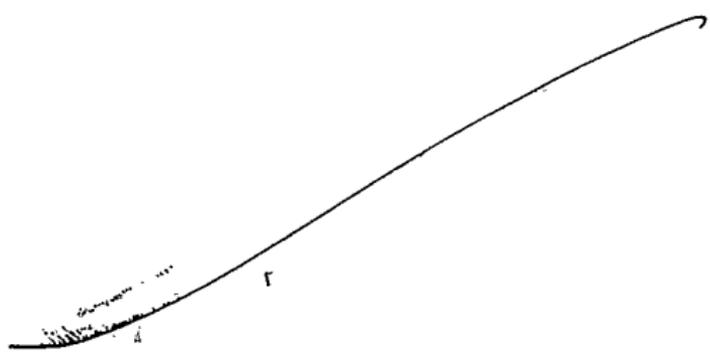

Misc Small Maps.....	<i>One</i>
Cards.....	<i>20</i>
Tracing.....	<i>10</i>
France Map.....	<i>✓</i>
Scarborough Map.....	<i>✓</i>
Moody Map.....	<i>✓</i>
Ge logical Des:.....	
Moody Flat Book.....	