

KANSAS


FORM 51 5M 1-42 PETROL

Pratt

Section 34 Township 27 Range 11-W

Well No. #2 Bowers

Company Deep Rock

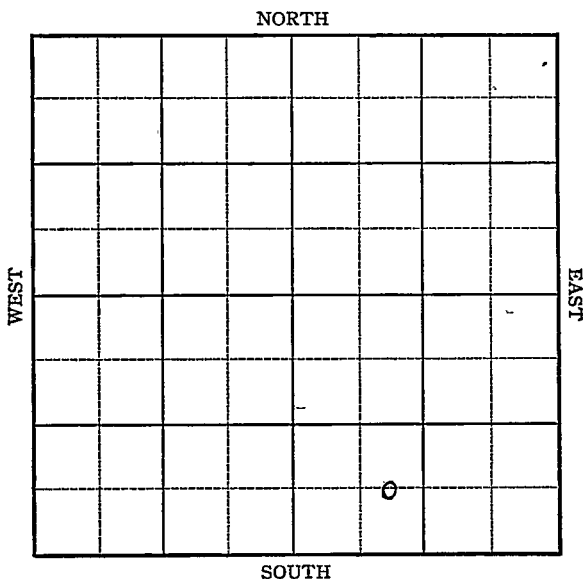

KANSAS

Pratt

Sec. 34 Twp. 27 R. 11-W

Well No. #2 Bowers Farm

Deep Rock Company


Cunningham

 Ft. from N. Line

660 Ft. from S. Line

 Ft. from E. Line

990 Ft. from W. Line

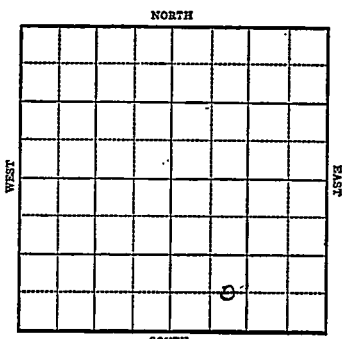

Elev. 1732

1943

R E P O R T

7/14	Location.
7/21	8" @ 391 Drlg. 1401'
7/28	Drlg. 3122
8/4	Lans 3481 Miss 3938 Drlg. 3984'
8/11	Viola 4134 T.D. 4164 5" @ 4164 Rust
8/18	48 shots 3500-16-6000 acid
8/25	16 shots 3535-39-1000 acid 4 fluid per hr.
9/1	Squeeze off perf.
9/8	" " "
9/15	" " "

OVER

1943

9/22 Viola 4143
5" © 4164
1800 acid
Water
T.D. 4209'

ABANDONED

Pratt

Map No. 125 Sec. 34 Twp. 27 R. 11WWell No. 2 BowersDeep Rock

Company

FIRST REPORT

Contractor

C EL SW SE

SECTION PLAT

 Ft. from N. Line660 Ft. from S. Line Ft. from E. Line990 Ft. from W. Line

CUNNINGHAM POOL

Location XXXRig up

Drilling and Remarks:

RECORD

Cased in., ft.Sand Gas Oil Total Depth

PRODUCTION

1st 24 hrs. Nat. 1st 24 hrs. after shot Gas Cu. Ft.Dry Hole Abandoned

Date

JUL 14 1943

19

S. J. LEWIS Scout

Misc. Small Maps *Qmga*
Cards *Qmga*
Tracing *MB*
France Map *C*
Scarborough Map *MB*
Moody Map *C*
Geological Dept. *C*
Moody Plat Book *C*

Map No. 54 Sec. 34 Twp. 27 R. 11WWell No. 2 BowersDeep Rock

Company

ABANDONED

Contractor

C E L SW SE

SECTION PLAT

Ft. from N. Line

660

Ft. from S. Line

Ft. from E. Line

990

Ft. from W. Line

Cunningham Pool

Location

Rig up

Drilling and Remarks:

Via 41435" @ 416418000 acidWater.

RECORD

Cased _____ in., _____ ft.

Sand _____

Gas _____

Oil _____

Total Depth 4209

PRODUCTION

1st 24 hrs. Nat. 1.5

1st 24 hrs. after shot _____

Gas _____ Cu. Ft.

Dry Hole _____

Abandoned _____

Date

SEP 22 1943

19

S. J. LEWIS Scout

Misc. Small Maps *Done*
Cards *Madge*
Tracing *Madge*
France Map *✓*
Scarborough Map *✓*
Moody Map *✓*
Geological Dept. *✓*
Moody Plat Book *✓*