


Section 35 Township 27 Range 40W

Well No. #5 Winger

Company United Prod.

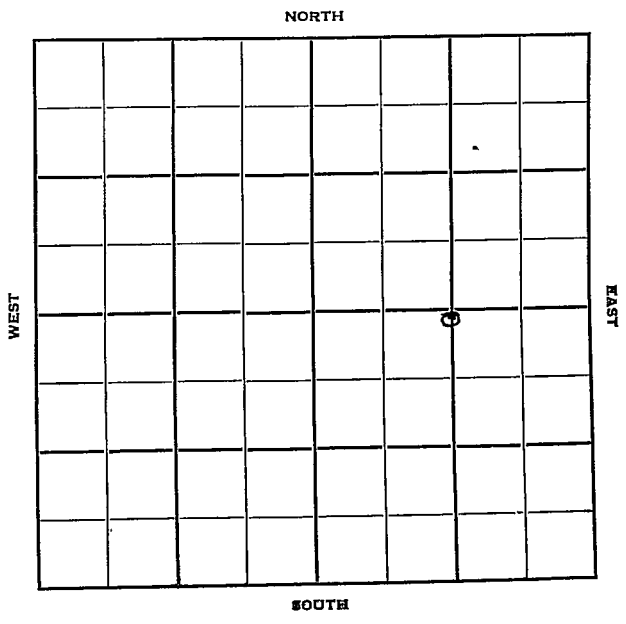

Stanton

KANSAS

Sec. 35 Twp. 27 R. 40 W

Well No. # 5 Winger Farm

United Prod. Company

Contractor

Hugoton Pool


50 Ft. from N. Line

Ft. from S. Line

1320 Ft. from E. Line

Ft. from W. Line

C N L N $\frac{1}{2}$ SE

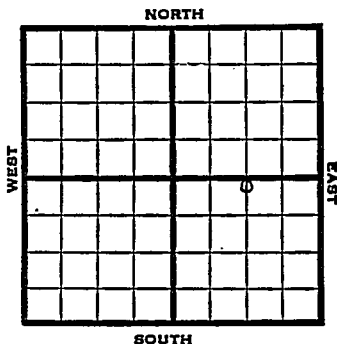

1951

Elev. 3221' REPORT

10/3

Location

11/21

Spud 10-6-51

Gas well TD 2370

10" @ 454' 7" @ 2241 TD 2370

Her. 2239 Kri. 2249

Win. 2300 Ft. Riley 2349

15000 A

Comp. 6,700,000 gas

COMPLETED

County **Stanton** State **Kansas**

Sec. **35** (Blk. Twp.) **27** (Sur. Rge.) **40W** Map No.

Operator **United Prod.**

Well No. **5** Farm **Winger**

Elev. Location **C N L N $\frac{1}{2}$ SE**

FIRST REPORT					
			0		

50 Ft. From **N** Line **SE**

1320 Ft. From **E** Line **Quarter**

Ist. Report **OCT 3 1951**

Completion

Remarks

Spudding Date

Drlg. Data **Hugoton Pool**

Location

