


KANSAS

Section 35 Township 27 Range 39WWell No. #1 Collingwood "B"Company Stanolind

NORTH

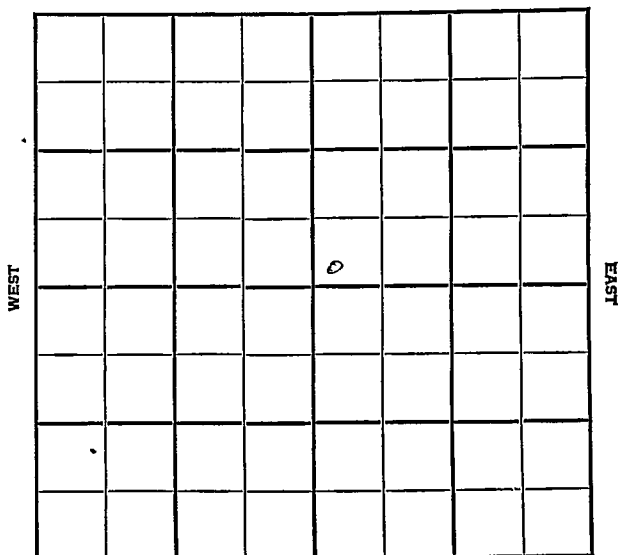

SOUTH

Sec. 35 Twp. 27 R. 39W

Well No. #1 Collingwood "B" Farm

Stanolind Company

Hugoton


 Ft. from N. Line

150 Ft. from S. Line

 Ft. from E. Line

150 Ft. from W. Line

SW NE

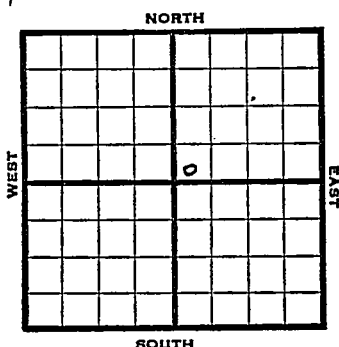

1947 Elev. 3150' REPORT

11/19	10" @ 708' TD 2315' Run Csg. Her. 2108'
11/25	7" @ 2308'
12/3	Dr1g. 2388'
12/10	7" @ 2308' 226' of 5" Perf. Liner @ 2518 16000 acid, 5,987,000 gas. 400# R. Pr. TD 2518'

COMPLETED

Map No. _____ Sec. 35 Twp. 27 R. 39W

Well No. 1 Collingwood "B"

Stanolind Company

FIRST REPORT

Contractor

SW NE


SECTION PLAT

_____ Ft. from N. Line

150 Ft. from S. Line

_____ Ft. from E. Line

150 Ft. from W. Line

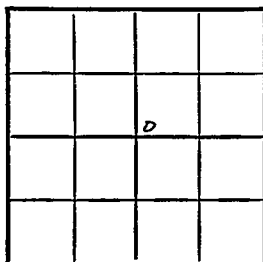

Stanton County

Location _____

Rig up _____

Drilling and Remarks:

10" @ 708

2315 TD

Run csg

Her. 2108

RECORD

Cased _____ in., _____ ft.

Sand _____

Gas _____

Oil _____

Total Depth _____

PRODUCTION

1st 24 hrs. Nat. _____

1st 24 hrs. after shot _____

Gas _____ Cu. Ft.

Dry Hole _____

Abandoned _____

Date

NOV 19 1947

19

S. J. LEWIS

Scout

Kansas

Map No. _____ Sec. 35 Twp. 27 R. 39WWell No. 1 Collingwood "B"

Stanolind _____ Company


COMPLETE

Contractor

SW NE

E13150

SECTION PLAT

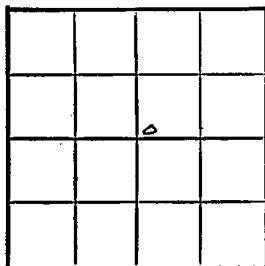

_____ Ft. from N. Line

150 Ft. from S. Line

_____ Ft. from E. Line

150 Ft. from W. Line

Stanton County

Location _____

Rig up _____

Drilling and Remarks:

7 "C21308"

216' of 5" Pay line
C21308.


5,987,000 Gas

400 # R.P.

RECORD

Cased _____ in., _____ ft.

Sand _____

Gas _____

Oil _____

Total Depth 2518'

PRODUCTION

1st 24 hrs. Nat. _____

1st 24 hrs. after shot _____

Gas _____ Cu. Ft.

Dry Hole _____

Abandoned _____

Date

DEC 10 1947

19

S. J. LEWIS

Scout