


Section 26 Township 27 Range 11W
Well No. 1 Hood
Company ROLAND PELT
Barbour Drlg.

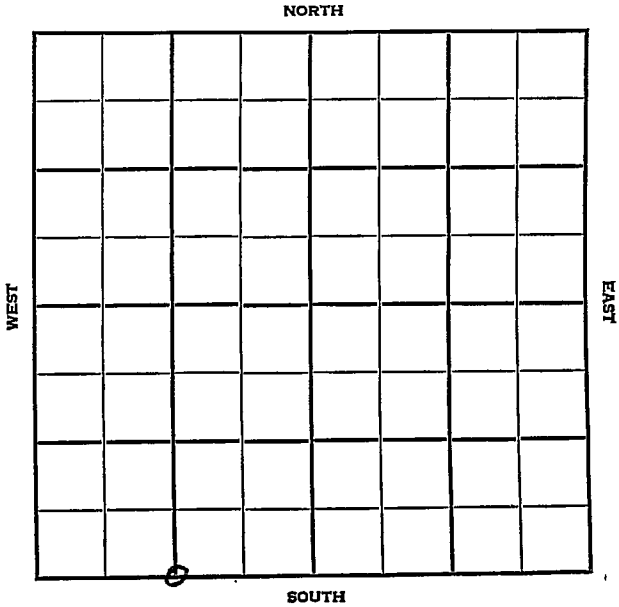

Pratt

KANSAS

SEC.	TWP.	R.
26	27	11W

WELL NO.

#1 Hood

FARM

COMPANY

~~Barbour Drilg.~~ ROLAND PELT

CONTRACTOR

~~-Co.-Tools.~~ Barbour Drilg.

Cunningham Pool


_____ Ft. from N. Line

_____ Ft. from S. Line

_____ Ft. from E. Line

1320 _____ Ft. from W. Line

C S Sec. line SW/4

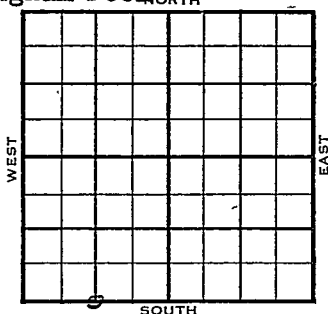

	ELEVATION	REPORT
1954	1685'	

11/17

M I R

12/15

Spud 11-15-54 D & A TD 4351

8" @ 210 Anhy 1250 Heeb 3314

Doug 3341

DST 3340-70 open 1½ hr rec 15' mud

706# Br. line 3494 Lans 3514

DST 3542-72 open 1 hr rec 35' SO &

GCM 57#

DST 3685-3715 open 1 hr rec 45' SO

& GCM 137# Miss 3972

DST 3971-92 open 1 hr. rec 35' GCM

49# Viola 4212

DST 4214-34 open 1 hr rec 30' GCM


62# Simp. 4316

DST 4321-51 open 1 hr rec 145' wtr.

440# TD 4351 D & A

ABANDONED

County **Pratt** State **Kansas**
 Sec. **26** (Blk. Twp.) **27** (Sur. Rge.) **11W** Map No.
 Operator **Barbour Drlg.**
 Well No. **1** Farm **Hood**
 Elev. **1685** Location **C S Sec. line SW/4**

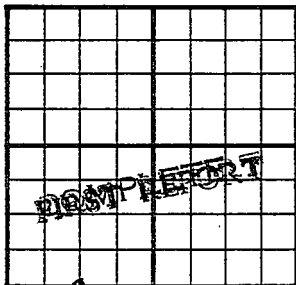

Ft. From Line
1320 Ft. From **W** Line Quarter
 Ist. Report **NOV 17 1954**
 Completion
 Remarks
Co. tools
 Spudding Date

Drlg. Data

Cunningham Pool**M I R****FABEN GILSTRAP**

Nov 18 1954


Drig. Data

Kansas

Map No. _____ Sec. 26 Twp. 27 R. 11WWell No. 1 HoodRoland Pelt

Company

CORRECTION

Contractor

C S Sec. line SW/4


SECTION PLAT

_____ Ft. from N. Line

_____ Ft. from S. Line

1320 Ft. from E. Line

_____ Ft. from W. Line

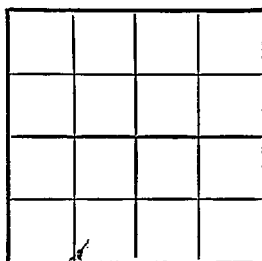Pratt County

Location _____

Rig up _____

Drilling and Remarks:

Reported
Barbour Drlg.

RECORD

Cased _____ in., _____ ft.

Sand _____

Gas _____

Oil _____

Total Depth _____

PRODUCTION

1st 24 hrs. Nat. _____

1st 24 hrs. after shot _____

Gas _____ Cu. Ft.

Dry Hole _____

Abandoned _____


Date

NOV 23 1954 19FABEN CULSTAD

Scout

NOV 26 1954

Scout Cards
Land Small Map
Land Wall Map
Tracings
France Map
Pierce Map
Misc.

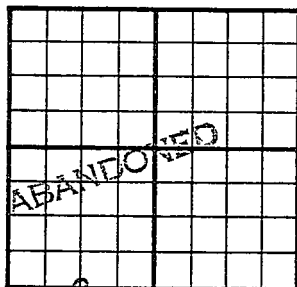County Pratt State KansasSec. 26 (Blk.
Twp.) 27 (Sur.
Rge.) 11W Map No.Operator Roland PeltWell No. 1 Farm HoodElev. 1685 Location C S Sec. line SW/4

Ft. From Line

1320 Ft. From W Line Quarter

1st. Report

Completion DEC 15 1954Remarks Cunningham Pool
Barbour - Contr.Spudding Date 11-15-54Drig. Data D & A TD 43518" @ 210 Anhy 1250 Heeb. 3314Doug. 3341 DST 3340-70 open 1½ hr.Rec. 15' mud 706# Br. lime 3494Lans. 3514 DST 3542-72 open 1 hr.Rec. 35' so & gcm 57# DST 3685-3715open 1 hr. Rec. 45' so & gcm 137#Miss. 3972 DST 3971-92 open 1 hr.Rec. 35' gcm 49# Viola 4212DST 4214-34 open 1 hr. Rec. 30' gcm62# Simp. 4316 DST 4321-51 open 1 hr.Rec. 145' wtr. 440# TD 4351D & A

FABEN GILSTRAP

Scout Cards	<i>mm</i>
Land Signal Map	
Land Trail Map	<i>3</i>
Tracings	
France Map	
Pierce Map	

DEC 23 1957

Drig. Data