

KANSAS


Pratt

FORM 51 5M PETROL

Section 35 Township 27 Range 11-W


Well No. #1 Fitzsimmons

Company Ohio

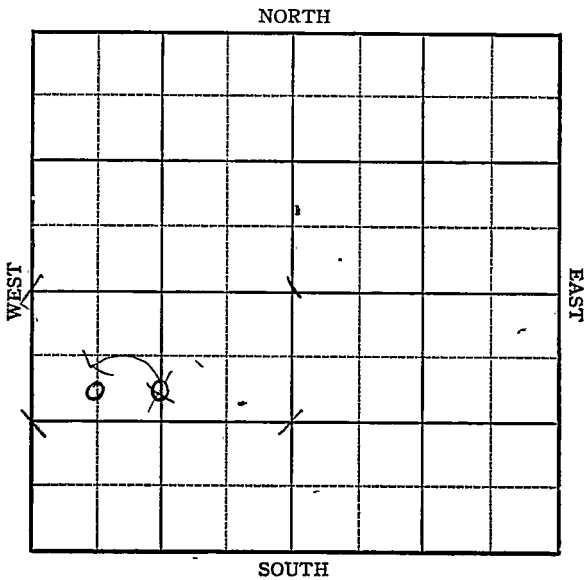

KANSAS

Pratt

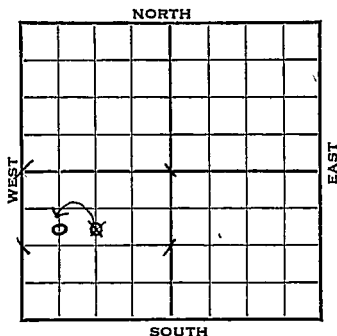Sec. 35 Twp. 27 R. 11-WWell No. #1 Fitzsimmons FarmOhio Company990 Ft. from N. Line         Ft. from S. Line~~1320~~ Ft. from E. Line660 Ft. from W. Line

1943

*elev. 1722*

REPORT

8/18

Location

8/25

8" @ 364'  
WOC.

9/1

Drlg. 3423'

9/8

3450' fsg.

9/15

Lans 3480  
T.D. 3496 SO  
5" @ 3482  
Rust

9/22

T.D. 3501  
Swab 55 oil & 25 water in 7 hrs.

9/29

T.D. 3524-3000 acid  
Swab 32½ oil in 1 hr.

10/6

Lans 3480  
5" @ 3482  
3000 acid  
Flow 115 Pot.  
Gravity 38.7  
T.D. 3524'

COMPLETED

KANSAS

Map No. 54 Sec. 35 Twp. 27 R. 11WWell No. 1 FitzsimmonsOhio

Company

FIRST REPORT

Contractor

C S L N $\frac{1}{2}$  SW

990

Ft. from N. Line


Ft. from S. Line

1320

Ft. from E. Line

Ft. from W. Line

## SECTION PLAT

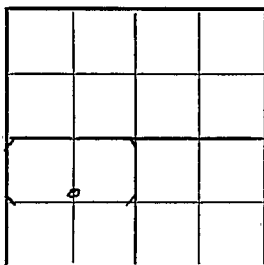

## CUNNINGHAM POOL

Location X

Rig up

Drilling and Remarks:

## RECORD

Cased \_\_\_\_\_ in., \_\_\_\_\_ ft.

Sand \_\_\_\_\_

Gas \_\_\_\_\_

Oil \_\_\_\_\_

Total Depth \_\_\_\_\_

## PRODUCTION

1st 24 hrs. Nat. \_\_\_\_\_

1st 24 hrs. after shot \_\_\_\_\_

Gas \_\_\_\_\_ Cu. Ft.


Dry Hole \_\_\_\_\_

Abandoned \_\_\_\_\_

Date

AUG 1 8 1943 19

S. J. LEWIS Scout

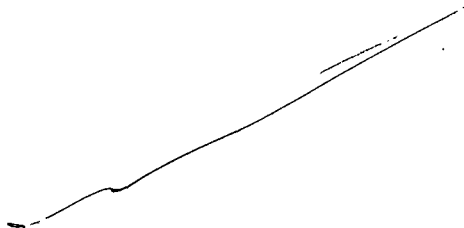

|                  |                 |
|------------------|-----------------|
| Misc Small Maps  | <i>Original</i> |
| Cards            | <i>Bea Top</i>  |
| Tracing          | <i>WED</i>      |
| France Map       | <i>✓</i>        |
| Scarborough Map  | <i>✓</i>        |
| Moody Map        | <i>✓</i>        |
| Geological Dept. |                 |
| Moody Flat Book  |                 |


Pratt

KANSAS

Map No. 54 Sec 35 Twp. 27 R. 11WWell No. 1 FitzsimmonsOhio CompanyCORRECTION Contractor

C S L NW SW

## SECTION PLAT

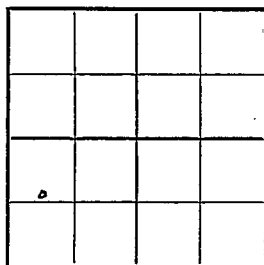990 Ft. from N. Line       Ft. from S. Line       Ft. from E. Line660 Ft. from W. LineCunningham PoolLocation                                 Rig up                                 

Drilling and Remarks:

Reported  
C S L N $\frac{1}{2}$  SW

## RECORD


Cased            in.,            ft.Sand                                 Gas                                 Oil                                 Total Depth                                 

## PRODUCTION

1st 24 hrs. Nat.                                 1st 24 hrs. after shot                                 Gas                                  Cu. Ft.Dry Hole                                 Abandoned                                 

Date

SEP 1 1943 19S. J. LEWIS Scout

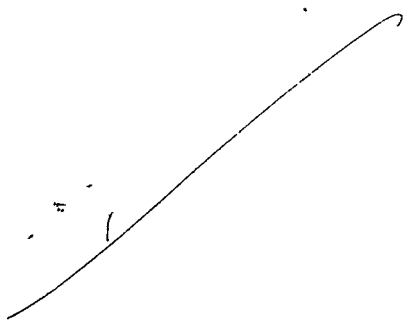

|                  |              |
|------------------|--------------|
| Misc Small Maps  | <i>Orig</i>  |
| Cards            | <i>See 6</i> |
| Tracing          | <i>WGL</i>   |
| France Map       | <i>✓</i>     |
| Scarborough Map  | <i>✓</i>     |
| Moody Map        | <i>✓</i>     |
| Geological Dept. | <i>✓</i>     |
| Moody Flat Book  |              |

KANSAS

Map No. 54 Sec. 35 Twp. 27 R. 11WWell No. 1 FitzsimmonsOhio

Company

COMPLETED

Contractor

C S L NW SW

## SECTION PLAT

|   |  |  |  |
|---|--|--|--|
|   |  |  |  |
|   |  |  |  |
|   |  |  |  |
| o |  |  |  |
|   |  |  |  |

990 Ft. from N. Line Ft. from S. Line Ft. from E. Line660 Ft. from W. LineCunningham PoolLocation Rig up 

Drilling and Remarks:

Lease 84805" @ 84823000 acidFlow. 115 Bbl.382 G

## RECORD

Cased  in.,  ft.Sand Gas Oil Total Depth 3524

## PRODUCTION


1st 24 hrs. Nat. 1st 24 hrs. after shot Gas  Cu. Ft.Dry Hole Abandoned 

Date

OCT 6 1943

19

S. J. LEWIS Scout

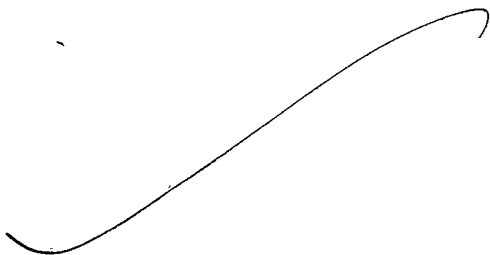

32. up3 *Ona*

|                   |             |
|-------------------|-------------|
| Car o             | <i>made</i> |
| Trig. 3           | <i>ME</i>   |
| France Map        | <i>/</i>    |
| Scarborough Map   | <i>/</i>    |
| Picrao Pic.       | <i>/</i>    |
| Cerological Dept. | <i>/</i>    |
| Flame Plot Book   | <i>/</i>    |