

KANSAS

Section 35 Township 27 Range 11W

Well No. 3 Fitzsimmons "A"

Company Skelly

Cunningham Pool

NORTH

WEST								EAST

SOUTH



Sec. 35 Twp. 27 R. 11-W

Well No. #3 Fitzsimmons "A" Farm

Skelly Company

Cunningham Pool


 Ft. from N. Line

330 Ft. from S. Line

990 Ft. from E. Line

 Ft. from W. Line

SW SE SW

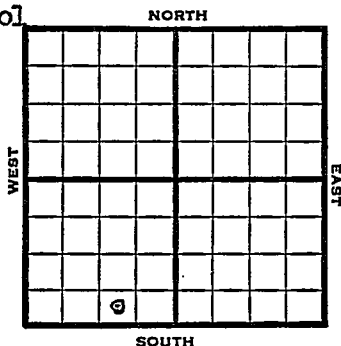

1948	Elev. 1719' REPORT
11/3	8" @ 403'
11/10	Drlg 2850'
11/16	Lansing 3486'
	TD 3520'
	5" @ 3510'
11/23	"
11/30	TD 3524
	3000 acid
	Pump 50 bbls oil, 12 hrs.
12/6	"
12/14	"
12/22	"
12/29	"
1949	
1/5	Lans. 3486'
	5" @ 3510'
	3000 acid
	Pump 50 oil Pot.
	Gr. 39°
	TD 3524'
	COMPLETED

Map No. _____ Sec. 35 Twp. 27 R. 11W

Well No. 3 Fitzsimmons "A"

Skelly _____ Company

FIRST REPORT

_____ Contractor

SW SE SW

SECTION PLAT

_____ Ft. from N. Line

330 Ft. from S. Line

990 Ft. from E. Line

_____ Ft. from W. Line

Pratt County

Location _____

Rig up _____

Drilling and Remarks:

8" @ 403

RECORD

Cased _____ in., _____ ft.

Sand _____

Gas _____

Oil _____

Total Depth _____

PRODUCTION

1st 24 hrs. Nat. _____

1st 24 hrs. after shot _____

Gas _____ Cu. Ft.

Dry Hole _____

Abandoned _____

Date

NOV 3 1948 19 S. I. LEWIS Scout

Map No. 54 Sec. 35 Twp. 27 R. 11W

Well No. 3 Fitzsimmons "A"

Skelly Company


COMPLETE

Contractor

SW SE SW

E11718

SECTION PLAT

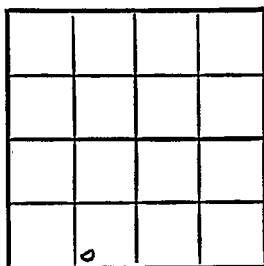

 Ft. from N. Line

330 Ft. from S. Line

990 Ft. from E. Line

 Ft. from W. Line

Pratt County

Location

Rig up

Drilling and Remarks:

Lane 3486.
5" @ 3510
3000 acid
Pump soil test
37-2

RECORD

Cased in., ft.

Sand

Gas

Oil ✓

Total Depth 3524

PRODUCTION

1st 24 hrs. Nat.

1st 24 hrs. after shot

Gas Cu. Ft.

Dry Hole

Abandoned

Date

JAN 5 1949 19

S. J. LEWIS Scout