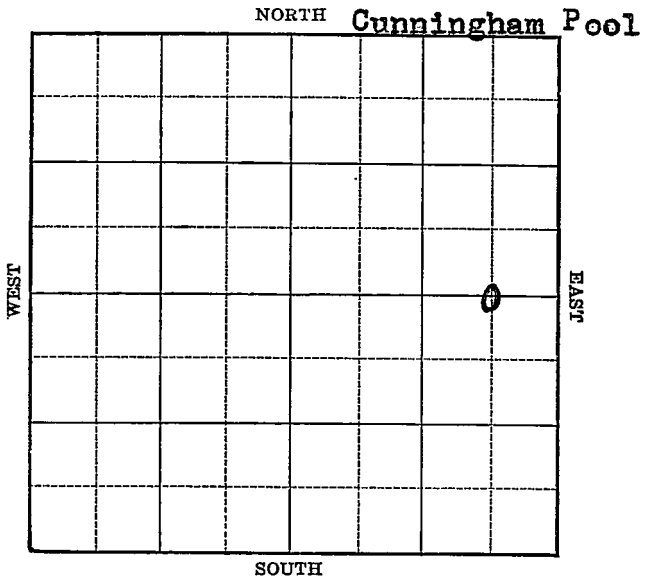


Pratt

KANSAS


Section 35 Township 27 Range 11-WWell No. #1 GerberCompany Drillers Gas

KANSAS

Pratt

Sec. 35 Twp. 27 R. 11-WWell No. #1 Gerber FarmDrillers Gas Company

(Cunningham)

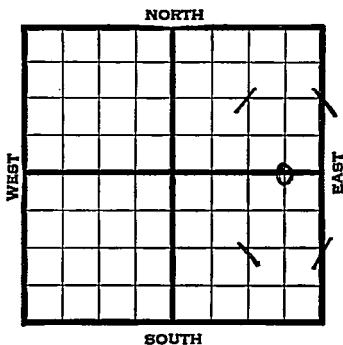2640 Ft. from N. Line Ft. from S. Line660 Ft. from E. Line Ft. from W. Line

1939

REPORT

8/16

Rotary.

8/24

10" - 388' WOC.

8/31

Drlg. 2074'

9/7

Drlg. 2830'

9/14

Lans. 3490' Drlg. 3940'

9/21

Viola 4122' 6" - 4124' T.D.
RUST.

9/27

Viola 4122'

6" - 4124'

T.D. 4142'

2000 acid.

28 M cu. ft. gas.

COMPLETED

Map No. 54 Sec. 35 Twp. 27 R. 11WWell No. 1 GerberDrillers Gas

Company

Contractor

FIRST REPORT

C $E\frac{1}{2}$ $E\frac{1}{2}$ Sec.2640 Ft. from N. Line Ft. from S. Line660 Ft. from E. Line Ft. from W. Line

CUNNINGHAM POOL

SECTION PLAT

Location Rig up Drilling and Remarks:
Rotary

RECORD

Cased in., ft.Sand Gas Oil Total Depth

PRODUCTION

1st 24 hrs. Nat. 1st 24 hrs. after shot Gas Cu. Ft.Dry Hole Abandoned

Date

AUG 16 1939₁₉S. J. LEWIS Scout

Misc. Small Maps
Cards
Tracing
France Map
Scarborough Map
Moody Map
Geological Dept.
Moody Flat Book

Handwritten signatures and initials:
- Over "Misc. Small Maps": *Ray*
- Over "Cards": *Ray*
- Over "Tracing": *Ray*
- Over "France Map": *Ray*
- Over "Scarborough Map": *Ray*
- Over "Moody Map": *Ray*

Pratt

KANSAS

Map No. 54 Sec. 35 Twp. 27 R. 11WWell No. 1 Gerber

Drillers Gas

Company

Contractor

COMPLETED

C $E\frac{1}{2}$ $E\frac{1}{2}$ SEC.2640 Ft. from N. Line Ft. from S. Line660 Ft. from E. Line Ft. from W. Line

CUNNINGHAM POOL

SECTION PLAT

			/
			o
			/

Location Rig up

Drilling and Remarks:

*Viola 4122**6" @ 4124**2000 acid**28M Gas* *✓*

RECORD

Cased in., ft.Sand Gas Oil Total Depth 4142

PRODUCTION

1st 24 hrs. Nat. 1st 24 hrs. after shot Gas Cu. Ft.Dry Hole Abandoned

Date

SEP 27 1939S. J. LEWIS

Scout

Misc Small Maps

Cards

Tracing

clap

Map

p

u