

KANSAS


Pratt

FORM 51 5M 1-42 PETROL

Section 35 Township 27 Range 11-W

Well No. #2 Fitzsimmons


Company Skelly Oil.

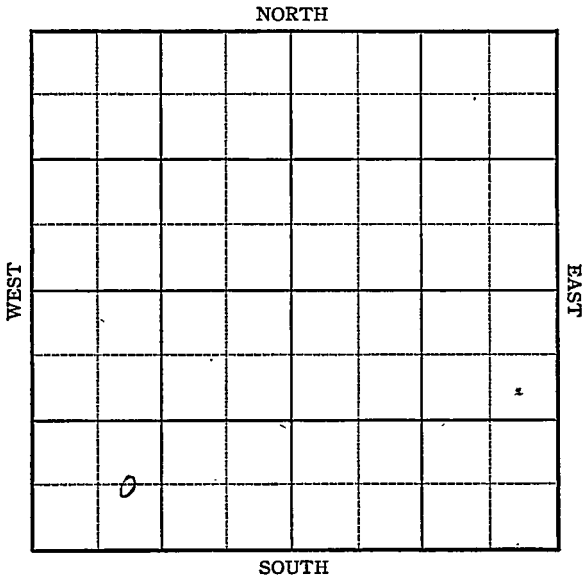

KANSAS

Sec. 35 Twp. 27 R. 11-W PrattWell No. #2 Fitzsimmons FarmSkelly Oil Company

Cunningham m

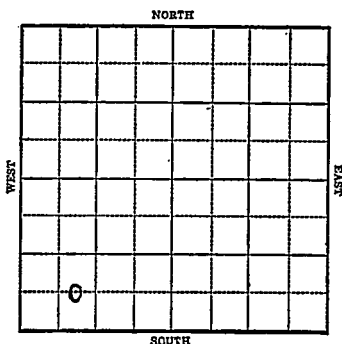 Ft. from N. Line660 Ft. from S. Line Ft. from E. Line990 Ft. from W. Line

Elev. 1726

1943

R E P O R T

7/21 Location.
7/28 Derrick
8/4 8 @ 361
WOC.
8/11 Drlg. 2605'
8/18 Lans 3487-97 T.D.
5" @ 3488'
Rust.
8/25 Pay 3502-26
T.D. 3527-1000' oil 1 hr.
9/1 4000 acid
9/8 Flow 163 oil in 5 hrs.
9/15 Lans 3487
5" @ 3488
4000 acid
Pump 500 Pot.
T.D. 3527
Gravity 36

COMPLETED

KANSAS
Map No. 54 Sec. 35 Twp. 27 R. 11WWell No. 2 Fitzsimmons

Skelly Oil

Company

FIRST REPORT

Contractor

C E L SW SW

SECTION PLAT

2			

Ft. from N. Line

660

Ft. from S. Line

Ft. from E. Line

990

Ft. from W. Line

CUNNINGHAM POOL

Location **X**

Rig up

Drilling and Remarks:

RECORD

Cased _____ in., _____ ft.

Sand _____

Gas _____

Oil _____

Total Depth _____

PRODUCTION

1st 24 hrs. Nat. _____

1st 24 hrs. after shot _____

Gas _____ Cu. Ft.

Dry Hole _____

Abandoned _____

Date

JUL 21 1943

19

S. J. LEWIS

Scout

Misc Small Maps

Cards

Tracing

France Map

Scarborough Map

Moody Map

Cerological Dept.

Moody Flat Book

KANSASMap No. 54 Sec. 35 Twp. 27 R. 11WWell No. 2 FitzsimmonsSkelly Oil CompanyCOMPLETED Contractor

C E L SW SW

 Ft. from N. Line660 Ft. from S. Line Ft. from E. Line990 Ft. from W. Line

SECTION PLAT

Cunningham PoolLocation Rig up

Drilling and Remarks:

*Lease 8487**5103488**4000 acid**Pump 500 RY**36° E*

RECORD


Cased in., ft.Sand Gas Oil Total Depth 3527

PRODUCTION

1st 24 hrs. Nat. 1st 24 hrs. after shot Gas Cu. Ft.Dry Hole Abandoned

Date

SEP 15 1943 19S. J. LEWIS Scout

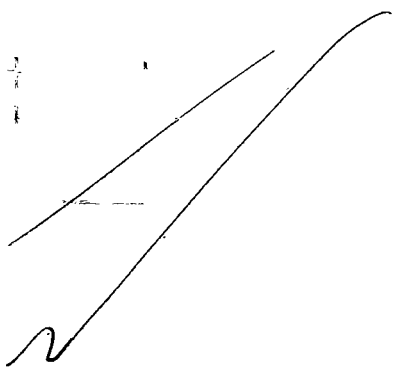

M

Misc. Small Maps	_____
Cards	<i>Bridge</i>
Tracing	<i>MOE</i>
France Map	☒
Scarborough Map	☒
Moody Map	☒
Geological Dept.	_____
Moody Plat Book	_____