


Section 35 Township 27 Range 11W

Well No. 4 Fitzsimmons

Company Drillers Gas

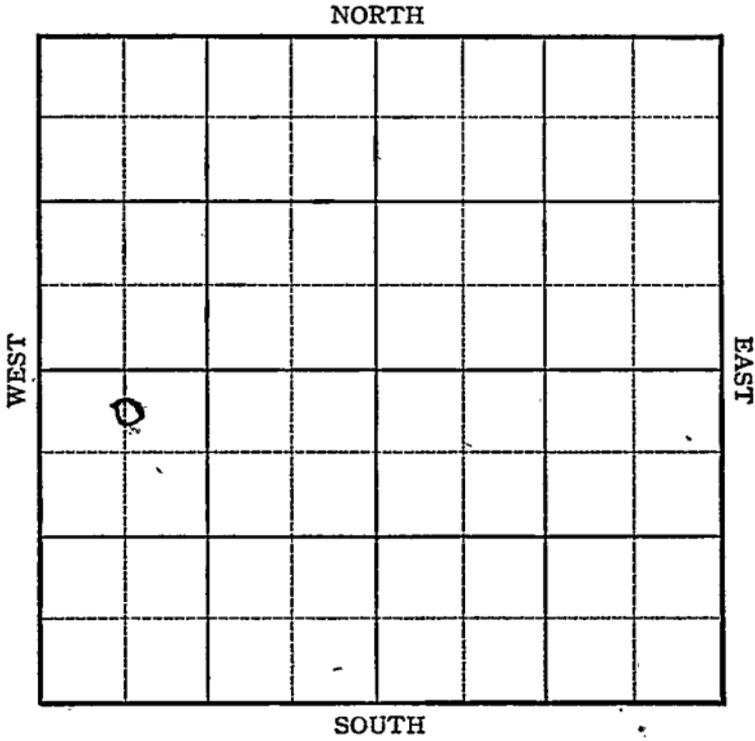



Sec. 35 Twp. 27 R. 11W

Well No. #4 Fitzsimmons Farm

Drillers Gas

Company


Cunningham

330 Ft. from N. Line

\_\_\_\_\_ Ft. from S. Line

\_\_\_\_\_ Ft. from E. Line

660 Ft. from W. Line

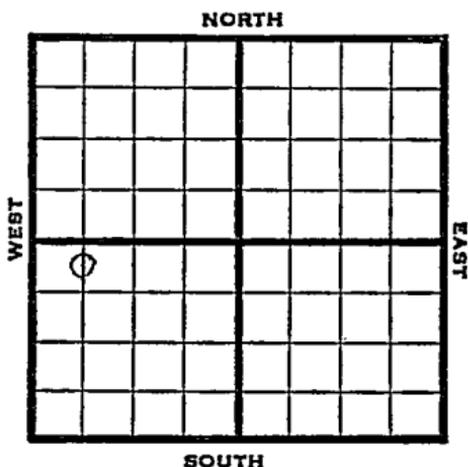

CNL NW SW

1946	Elev. 1711	REPORT
4/24	RUR	
5/1	8" @ 403 Drlg 1973'	
5/7	Anhy 445 Doug. 3340 Lans 3477 TD 3500 SO Run 5"	
5/14	TD 3515 5" @ 3498-5000 acid	
5/21	PB 3511 $\frac{1}{2}$ , Swb 100 fluid in 3 hrs	
5/29	Pump 48 oil plus 52 Wtr. in 6 hrs.	
6/5	" " " " "	
6/12	" " " " "	
6/18	" " " " "	
6/26	Lans 3477 5" @ 3498 5000 acid. TD 3515' Pump 45 oil plus 150 W. Pot. Grav. 38.0	

COMPLETED



