

KANSAS

FORM 51 SM 10-41 PETROL


Pratt

Section 35 Township 27 Range 11-W

Well No. 3 Gerber

Company Drillers Gas

NORTH Cunningham pool

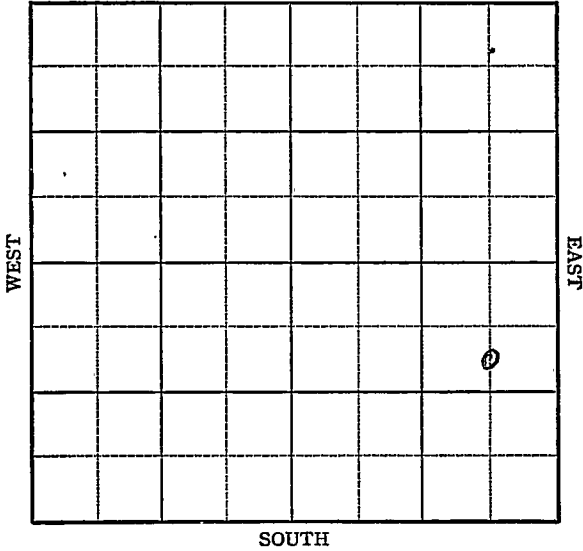

Sec. 35 Twp. 27 R. 11-W

Well No. #3 Gerber Farm

Drillers Gas Company

(Cunningham)


990 Ft. from N. Line

_____ Ft. from S. Line

660 Ft. from E. Line

_____ Ft. from W. Line

Elev. 1719

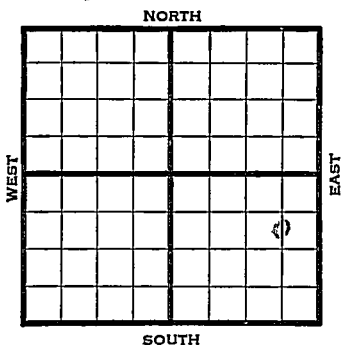

1941	REPORT
12/3	Moving in rotary.
12/11	Drlg. 200'
12/18	8" @ 461
	Drlg. 2580
12/24	Lans. 3483' T.D. 3626'
	5" - 3626' RUST.
12/31	T.D. 3580' 83 shots 3490-3526'
	1/2 oil per hour, S.W.
1942	
1/8	5000 acid. Flow 25 oil per hour
	8 hours.
1/15	" " "
1/21	Lans. 3483'
	5" - 3622'
	T.D. 3580'
	83 shots 3490-3526'
	5000 acid.
	Potential 864 bbls., pump.
	41. Gravity
	COMPLETED

Map No. 54 Sec. 35 Twp. 27 R. 11WWell No. 3 GerberDrillers Gas

Company

FIRST REPORT

Contractor

C $S\frac{1}{2}$ NE SE990 Ft. from N. Line

_____ Ft. from S. Line

660 Ft. from E. Line

_____ Ft. from W. Line

SECTION PLAT

			o

CUNNINGHAM POOL

Location _____

Rig up _____

Drilling and Remarks:

Moving inRotary

RECORD

Cased _____ in., _____ ft.

Sand _____

Gas _____

Oil _____

Total Depth _____

PRODUCTION

1st 24 hrs. Nat. _____

1st 24 hrs. after shot _____

Gas _____ Cu. Ft.

Dry Hole _____

Abandoned _____

Date

DEC 3 1941 19S. J. LEWIS Scout

Pratt

KANSAS

Map No. 54 Sec. 35 Twp. 27 R. 11WWell No. 3 GerberDrillers Gas

Company

COMPLETED

Contractor

C S $\frac{1}{2}$ NE SE990 Ft. from N. Line

_____ Ft. from S. Line

660 Ft. from E. Line

_____ Ft. from W. Line

SECTION PLAT

			o

CUNNINGHAM POOL

Location _____

Rig up _____

Drilling and Remarks:

*Lease 3483**5" @ 3622**834 to 3490 - 3526**5000 acid**Pump 16 1/2" P.S.**41 1/2" G.S.*

RECORD

Cased _____ in., _____ ft.

Sand _____

Gas _____

Oil _____

Total Depth 3580

PRODUCTION

1st 24 hrs. Nat. _____

1st 24 hrs. after shot _____

Gas _____ Cu. Ft.

Dry Hole _____

Abandoned _____

Date

JAN 21 1942 19

S. J. LEWIS Scout