

KANSAS


Pratt

FORM 51 5M 4-41 PETROL

Section 35 Township 27 Range 11-W

Well No. #2 Silton

Company Sam Springer

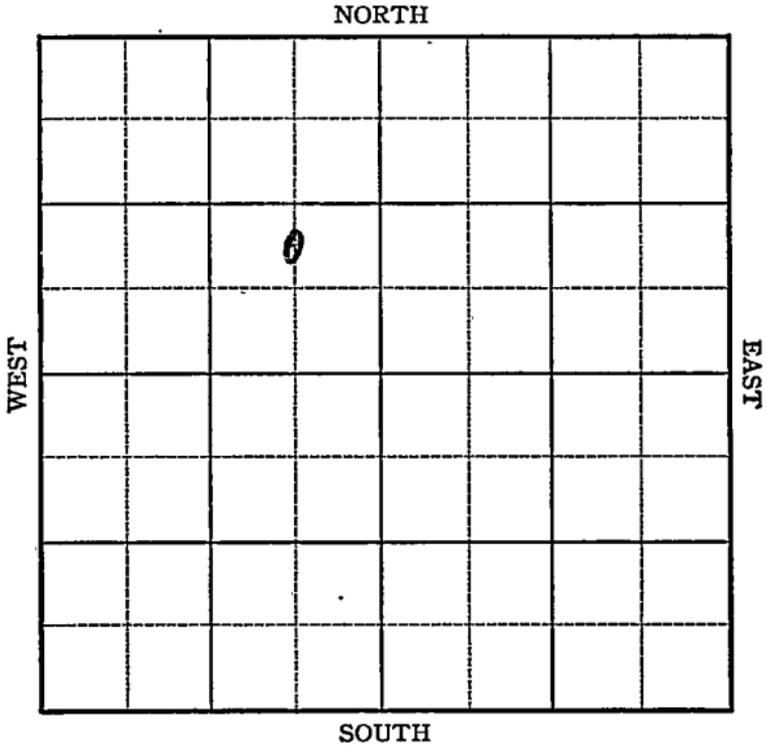


Sec. 35 Twp. 27 R. 11-WWell No. #2 Silton FarmSam Springer Company

(Cunningham)

 Ft. from N. Line990 Ft. from S. Line660 Ft. from E. Line Ft. from W. Line

Elev. 1697

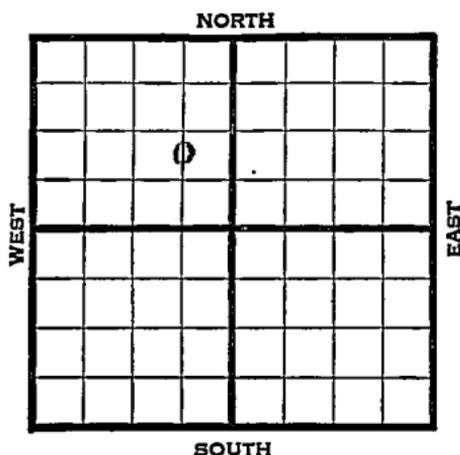

1941	REPORT
10/22	Location
10/30	Derrick.
11/6	"
11/13	8" - 470' Drlg. 1950'
11/20	Drlg. 3300'
11/28	Lans. 3461' 5" - 3550'
	T.D. 3550' RUST.
12/4	70 shots 3462-96' 400' oil 4 hr
	5000 acid. C.O.
12/11	Flow 25 oil per hour.
12/18	Drlg. 3400
12/24	" "
12/30	Lans. 3461 5" @ 3550
	70 shots 3462-96
	TD 3550
	5000 acid
	Pump 656 oil Potential
	41 Grav. COMPLETED

Pratt **KANSAS**Map No. 11-55 Sec. 35 Twp. 27 R. 11WWell No. 2 SiltonSam Springer Company**FIRST REPORT** Contractor

C NL SE NW

 Ft. from N. Line990 Ft. from S. Line660 Ft. from E. Line Ft. from W. Line

SECTION PLAT

	o		

CUNNINGHAM POOL

Location XXRig up Drilling and Remarks:

RECORD

Cased in., ft.Sand Gas Oil Total Depth

PRODUCTION

1st 24 hrs. Nat. 1st 24 hrs. after shot Gas Cu. Ft.Dry Hole Abandoned

Date

OCT 22 1941 19S. J. LEWIS Scout

Misc. Small Maps
 Cards
 Tracing
 France Map
 Scarborough Map
 Moody Map
 Geological Dept.
 Moody Plat Book

Handwritten signatures and initials:
 (Large signature over Misc. Small Maps)
 (Initials over Cards)
 (Initials over Tracing)
 (Signature over France Map)
 (Signature over Scarborough Map)
 (Signature over Moody Map)

Pratt

KANSAS

Map No. 54 Sec. 35 Twp. 27 R. 11W

Well No. 2 Sitton

Sam Springer Company

COMPLETED Contractor

C NL SE NW

SECTION PLAT

	o		

_____ Ft. from N. Line

990 Ft. from S. Line

660 Ft. from E. Line

_____ Ft. from W. Line

CUNNINGHAM POOL

Location _____

Rig up _____

Drilling and Remarks:

Lease 3461

5" @ 3558

70 skts to 3462-96.

5000 acid

Pump 656 x 6 1/2"

41 2/28

RECORD

Cased _____ in., _____ ft.

Sand _____

Gas _____

Oil _____

Total Depth 3558

PRODUCTION

1st 24 hrs. Nat. _____

1st 24 hrs. after shot _____

Gas _____ Cu. Ft.

Dry Hole _____

Abandoned _____

Date

DEC 30 1941 19

S. J. LEWIS

Scout

Misc. Small Maps *DAV*
Cards *DAV*
Tracing *DAV*
France Map *DAV*
Scarborough Map *DAV*
Moody Map *DAV*
Geological Dept. _____
Moody Flat Book _____