

# KANSAS


Pratt

FORM 51 5M 10-41 PETROL

Section 35 Township 27 Range 11-W

Well No. #5 Steffen "C"

Company Skelly

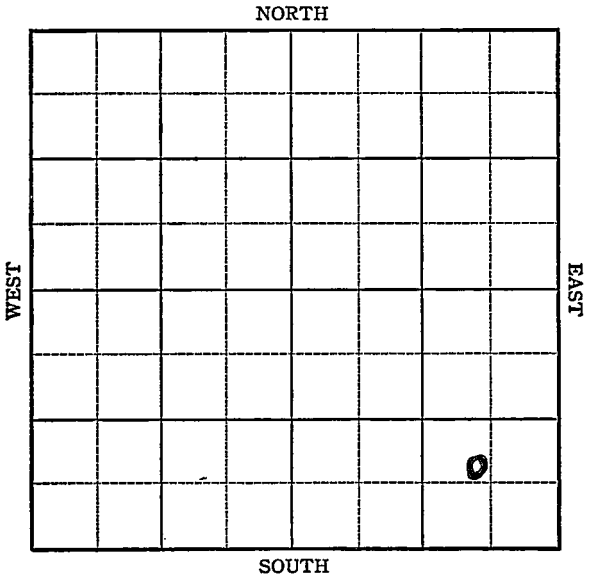

Sec. 35 Twp. 27 R. 11-W

Well No. #5 Steffen "C" Farm

Skelly Company


(Cunningham)

       Ft. from N. Line

766 Ft. from S. Line

766 Ft. from E. Line

       Ft. from W. Line

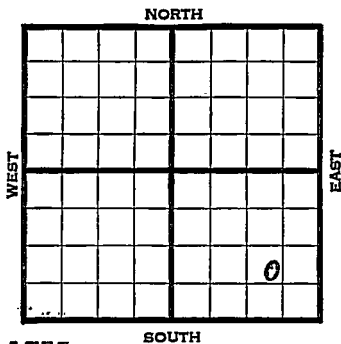

Elev. 1733

1942	REPORT
5/6	Rotary.
5/13	8" - 405' Drlg. 1980'
5/20	Drlg. 3285'
5/27	Lans. 3513' 5" - 3520'
	T.D. 3544' S.O.
6/3	8000 acid. Pump 64 fluid 24 hours,
	trace oil.
6/10	Lans. 3513'
	5" - 3520'
	T.D. 3544'
	8000 acid.
	Water.
	<b>ABANDONED</b>

Map No. 54 Sec. 35 Twp. 27 R. 11WWell No. 5 Steffen "C"Skelly

Company

**FIRST REPORT**

Contractor

C S E S E

**SECTION PLAT**

			o

\_\_\_\_\_ Ft. from N. Line

766 Ft. from S. Line766 Ft. from E. Line

\_\_\_\_\_ Ft. from W. Line

**CUNNINGHAM POOL**

Location \_\_\_\_\_

Rig up \_\_\_\_\_

Drilling and Remarks:

Rotary

**RECORD**

Cased \_\_\_\_\_ in., \_\_\_\_\_ ft.

Sand \_\_\_\_\_

Gas \_\_\_\_\_

Oil \_\_\_\_\_

Total Depth \_\_\_\_\_

**PRODUCTION**

1st 24 hrs. Nat. \_\_\_\_\_

1st 24 hrs. after shot. \_\_\_\_\_

Gas \_\_\_\_\_ Cu. Ft.

Dry Hole \_\_\_\_\_

Abandoned \_\_\_\_\_

Date

MAY 6 1942 19S. J. LEWIS

Scout

Misc. Small Maps  
Cards  
Tracing  
France Map  
Scarborough Map  
Moody Map  
Geological Dept.  
Moody Plat Book

Pratt

Map No. 54 Sec. 35 Twp. 27 R. 11W

Well No. 5 Steffen "C"

Skelly Company

**ABANDONED** Contractor

C SE SE

SECTION PLAT

\_\_\_\_\_ Ft. from N. Line

766 Ft. from S. Line

766 Ft. from E. Line

\_\_\_\_\_ Ft. from W. Line

			o

CUNNINGHAM POOL

Location \_\_\_\_\_

Rig up \_\_\_\_\_

Drilling and Remarks:

*Loss 3513  
5" @ 3520  
5000 acid  
Water*

RECORD

Cased \_\_\_\_\_ in., \_\_\_\_\_ ft.

Sand \_\_\_\_\_

Gas \_\_\_\_\_

Oil \_\_\_\_\_

Total Depth 3544

PRODUCTION

1st 24 hrs. Nat. \_\_\_\_\_

1st 24 hrs. after shot \_\_\_\_\_

Gas \_\_\_\_\_ Cu. Ft.

Dry Hole \_\_\_\_\_

Abandoned \_\_\_\_\_

Date

JUN 10 1942 19

S. I. LEWIS Scout

Misc Small Maps

Cards

Tracing

France Map

Scarborough Map

Moody Map

Geological Dept.

Moody Flat Book