


Section 36 Township 27 Range 36W

Well No. 1 Adams "B"

Company Columbian Fuel  
Hugoton

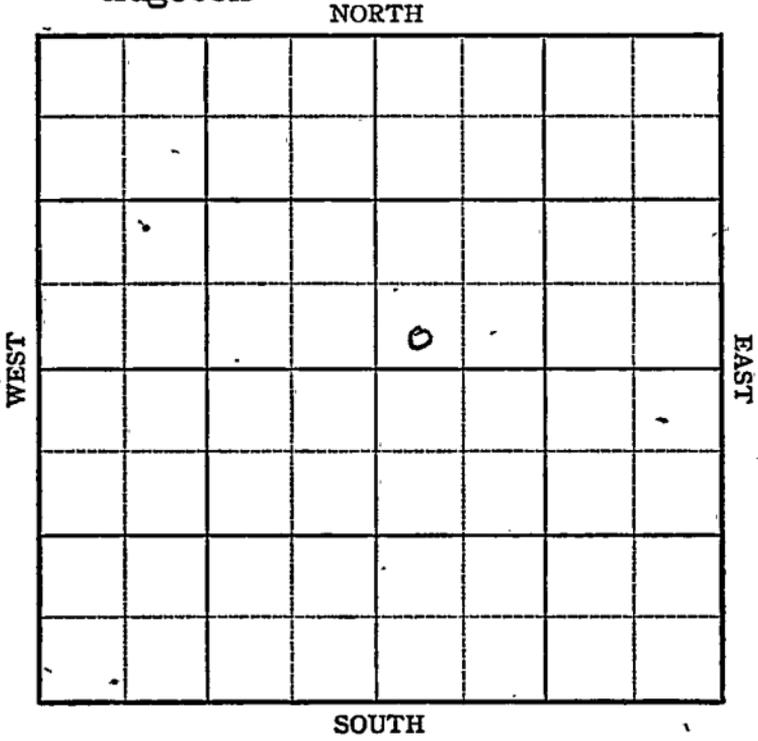

Grant

Sec. 36 Twp. 27 R. 36-W

Well No. #1 Adams Farm

Columbian Fuel Company


Hugoton Pool

2540 Ft. from N. Line

\_\_\_\_\_ Ft. from S. Line

2540 Ft. from E. Line

\_\_\_\_\_ Ft. from W. Line

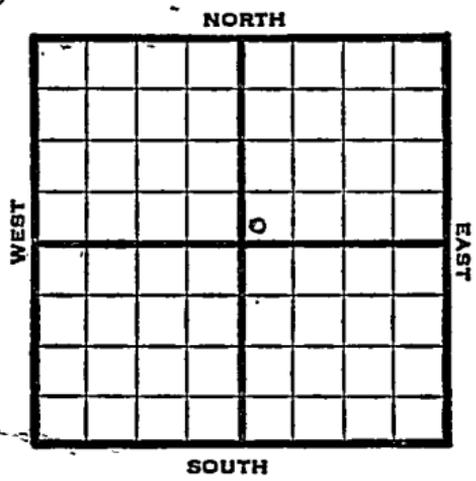

SW NE

1947 Elev. 3139' REPORT

- 3/19 Location
- 3/25 "
- 4/2 RUR
- 4/9 Surface hole.
- 4/15 10" @ 560'  
Drlg. 2250'
- 4/23 Drlg 2560'
- 4/29 TD 2573'  
7" @ 2564'  
RUST
- 5/7 2630' fsg.
- 5/13 TD 2801'  
243' of 5" Perf Liner @ 2801'
- 5/20 " "
- 5/27 " "

**OVER**

6/4

7" @ 2564'

243' of 5" Perf. Liner @ 2801'

15000 Acid

15,136,000 Gas.

409# R. Pr.

TD 2801'

**COMPLETED**

Map No. \_\_\_\_\_ Sec. 36 Twp. 27 R. 36W

Well No. 1 Adams "B"

Columbian Fuel Company

FIRST REPORT Contractor

SW NE

SECTION PLAT

2540 Ft. from N. Line

\_\_\_\_\_ Ft. from S. Line

2540 Ft. from E. Line

\_\_\_\_\_ Ft. from W. Line


Grant County

Location X

Rig up \_\_\_\_\_

Drilling and Remarks:

RECORD

Cased \_\_\_\_\_ in., \_\_\_\_\_ ft.

Sand \_\_\_\_\_

Gas \_\_\_\_\_

Oil \_\_\_\_\_

Total Depth \_\_\_\_\_

PRODUCTION

1st 24 hrs. Nat. \_\_\_\_\_

1st 24 hrs. after shot \_\_\_\_\_

Gas \_\_\_\_\_ Cu. Ft.

Dry Hole \_\_\_\_\_

Abandoned \_\_\_\_\_

Date .

MAR 19 1947 19

S. J. LEWIS Scout



Misc. Small Maps	_____
Cards	<i>OK</i>
Tracing	_____
France Map	<i>OK</i>
Scarborough Map	<i>OK</i>
Pierce Map	<i>OK</i>
Geological Sect.	_____
Pierce Plat Sect.	_____



1847  
1848

*Handwritten scribbles and a diagonal line with a small circle at the end.*

List Small Maps	<del>_____</del>
Cards	<u>REB</u>
Tracing	<u>✓</u>
France Map	<u>✓</u>
Conerough Map	<u>✓</u>
Meicall Map	<u>✓</u>
Cathedral Dept.	_____
Pierce Plat Book	_____