


Section 36 Township 27 Range 5-W

Well No. #2 Bryant

Company Westgate-Greenland

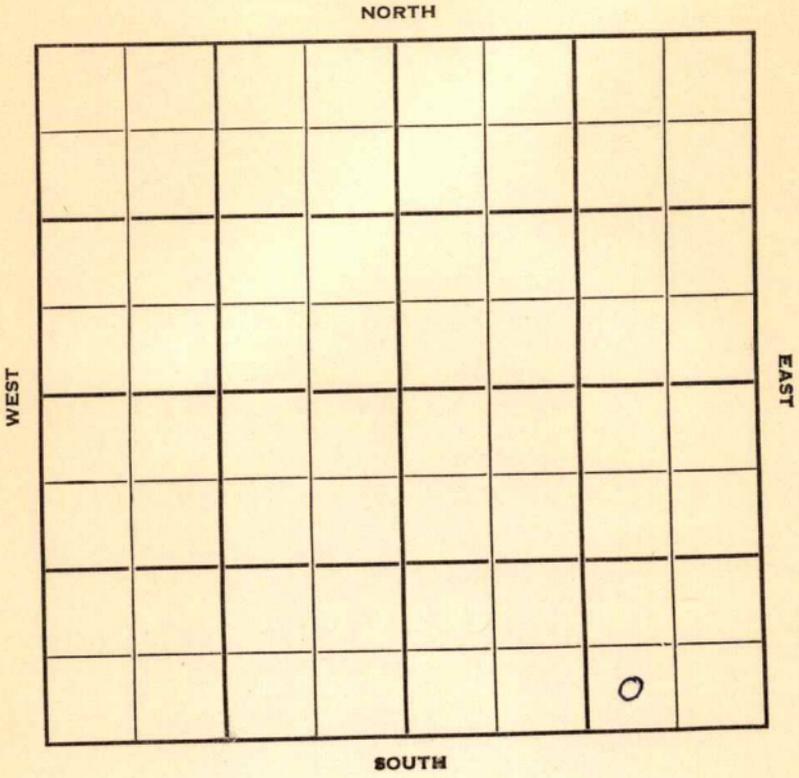

Sec. 36 Twp. 27 R. 5-W

Well No. #2 Bryant Farm

Westgate-Greenland Company

Jackson Contractor

Bartholomew


 Ft. from N. Line

330 Ft. from S. Line

990 Ft. from E. Line

 Ft. from W. Line

SW SE SE

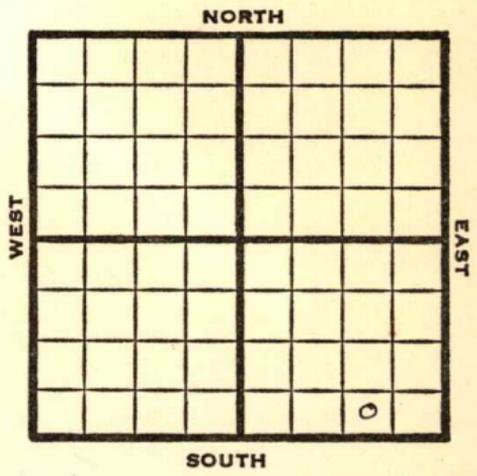

1950 **Elev. 1429'** REPORT

8/2 Spud 7-27-50
8 5/8" @ 217
drlg 2340

9/13 Spud 7-27-50
Oil Well TD 3779'
8-5/8" @ 217'
Br Lime 2865'
Miss Chat 3729'
Miss Dol 3773'
5" @ 3773'
TD 3779'
F/20 BOPH
Comp. 116 BOPD
COMPLETED

Map No. _____ Sec. 36 Twp. 27 R. 5W

Well No. 2 Bryant

Westgate-Greenland Company

Jackson Contractor

SW SE SE

SECTION PLAT



_____ Ft. from N. Line

330 Ft. from S. Line

990 Ft. from E. Line

_____ Ft. from W. Line

Kingman County

Location _____

Rig up _____

Drilling and Remarks:

Spud 7-27-50

8 5/8" @ 217

drlg. 2340

RECORD

Cased _____ in., _____ ft.

Sand _____

Gas _____

Oil _____

Total Depth _____

PRODUCTION

1st 24 hrs. Nat. _____

1st 24 hrs. after shot _____

Gas _____ Cu. Ft.

Dry Hole _____

Abandoned _____

Date

AUG 2 1950 19 _____

J. E. TYRA Scout

