

KANSAS


Pratt

Form 51—5M—7-40—Palace


Section 36 Township 27 Range 11-W

Well No. #3 Lakin

Company Skelly

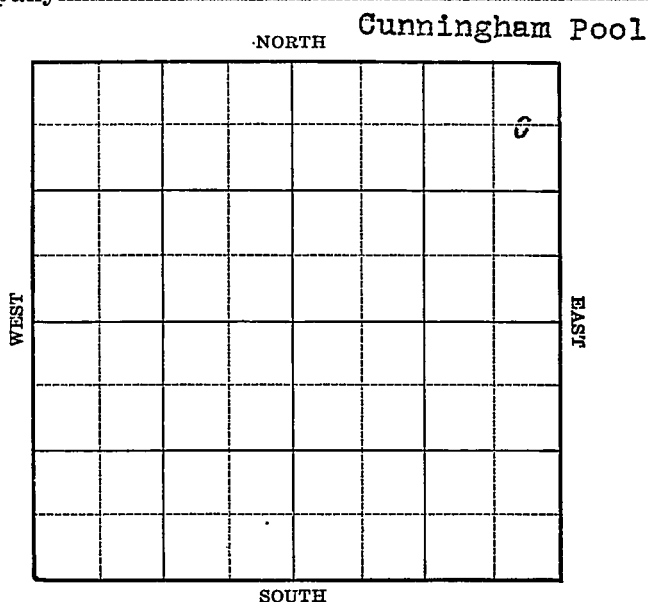

Company

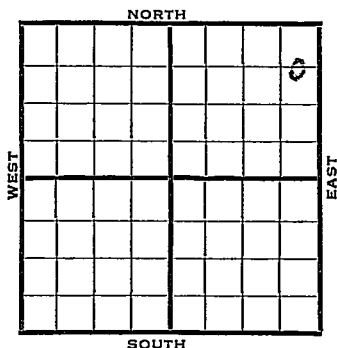

34.5 Gravity

~~CONFIDENTIAL~~

Map No. 53 Sec. 36 Twp. 27 R. 11WWell No. 3 LakinSkelly CompanyFIRST REPORT Contractor

SECTION PLAT

			o

C E L NE NE

660 Ft. from N. Line Ft. from S. Line330 Ft. from E. Line Ft. from W. Line

CUNNINGHAM POOL

Location Rig up

Drilling and Remarks:

Rotary

RECORD

Cased in., ft.Sand Gas Oil Total Depth

PRODUCTION

1st 24 hrs. Nat. 1st 24 hrs. after shot Gas Cu. Ft.Dry Hole Abandoned

Date

JAN 22 1941 19S. J. LEWIS Scout

Map No. 53 Sec. 36 Twp. 27 R. 11WWell No. 3 LakinSkelly Oil CompanyCOMPLETION Contractor

SECTION PLAT

660 C E L N E N E
Ft. from N. Line

Ft. from S. Line

330 Ft. from E. Line

Ft. from W. Line

CUNNINGHAM POOL

Location _____

Rig up _____

Drilling and Remarks:

*Lans. 3441**510 3448**7000 auct**Pump & Flow. 792. 85**34.5 Gr*

RECORD

Cased _____ in., _____ ft.

Sand _____

Gas _____

Oil _____

Total Depth 3504

PRODUCTION

1st 24 hrs. Nat. _____

1st 24 hrs. after shot _____

Gas _____ Cu. Ft.

Dry Hole _____

Abandoned _____

Date

FEB 26 19

S. J. LEWIS Scout