

Pratt

Section 36 Township 27 Range 11-W

Well No. #4 Lakin

Company Skelly

WEST

EAST

0

SOUTH

KANSAS

Pratt

Sec. 36 Twp. 27 R. 11-W

Well No. #4 Lakin Farm

Skelly Company


(Cunningham)

75 Ft. from N. Line

 Ft. from S. Line

60 Ft. from E. Line

 Ft. from W. Line

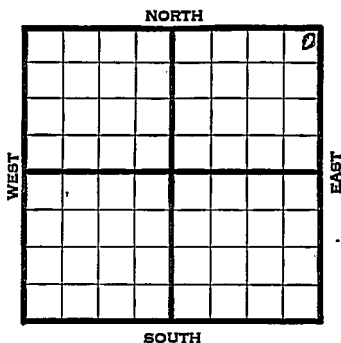

1941	REPORT
12/17	8" - 372'
	Drlg. 1825'
12/24	Drlg. 3275'
12/31	Lans. 3433-38' T.D. 5" - 3433'
	RUST.
1942	
1/8	"
1/15	"
1/22	"
1/29	"
2/5	"
2/12	"
2/19	"
2/26	Run liner.
3/5	T.D. 3495' 2000' Oil.
	Shut down.
3/12	" "
3/19	1000 acid.
	OVER

1942

3/25

Lans. 3433'

5" - 3433'

T.D. 3495'

Repressure hole for gas wells.

ABANDONED

Pratt

KANSAS

Map No. 54 Sec. 36 Twp. 27 R. 11WWell No. 4 LakinSkelly Company

Contractor

FIRST REPORT
NE/C

SECTION PLAT

			0

75 Ft. from N. Line

Ft. from S. Line

60 Ft. from E. Line

Ft. from W. Line

CUNNINGHAM POOL

Location

Rig up

Drilling and Remarks:

8" - 372'

Drlg. 1825'

RECORD

Cased _____ in., _____ ft.

Sand _____

Gas _____

Oil _____

Total Depth _____

PRODUCTION

1st 24 hrs. Nat. _____

1st 24 hrs. after shot _____

Gas _____ Cu. Ft.

Dry Hole _____

Abandoned _____

Date

DEC 17 1941

19

S. J. LEWIS

Scout

Misc. Small Maps	DAY
Cards	DAY
Tracing	DAY
France Map	DAY
Scarborough Map	DAY
Moody Map	
Geological Dept.	
Moody Flat-Book	

Pratt

KANSASMap No. 54 Sec. 36 Twp. 27 R. 11WWell No. 4 LakinSkelly

Company

~~COMPLETE~~

Contractor

NE/C **ABANDONED**

SECTION PLAT

			0

75 Ft. from N. Line Ft. from S. Line60 Ft. from E. Line Ft. from W. Line

CUNNINGHAM POOL

Location Rig up

Drilling and Remarks:

*Lane 3433**5" @ 3433**Re-pressure Hole
for Gas Well.*

RECORD

Cased in., ft.Sand Gas Oil Total Depth 3495

PRODUCTION

1st 24 hrs. Nat. 1st 24 hrs. after shot Gas Cu. Ft.Dry Hole Abandoned

Date

MAR 25 1942 19

S. J. LEWIS

Scout

Misc Small Maps	_____
Cards	_____
Tracing	_____
Prince Map	_____
Scarborough Map	_____
Moody Map	_____
Geological Dept.	_____
Moody Flat Book	_____