

# KANSAS

FORM 51 5M 4-41 PETROL


Pratt

Section 36 Township 27 Range 11-W

Well No. #1 McCellan "B"

Company Gulf

Cunningham Pool

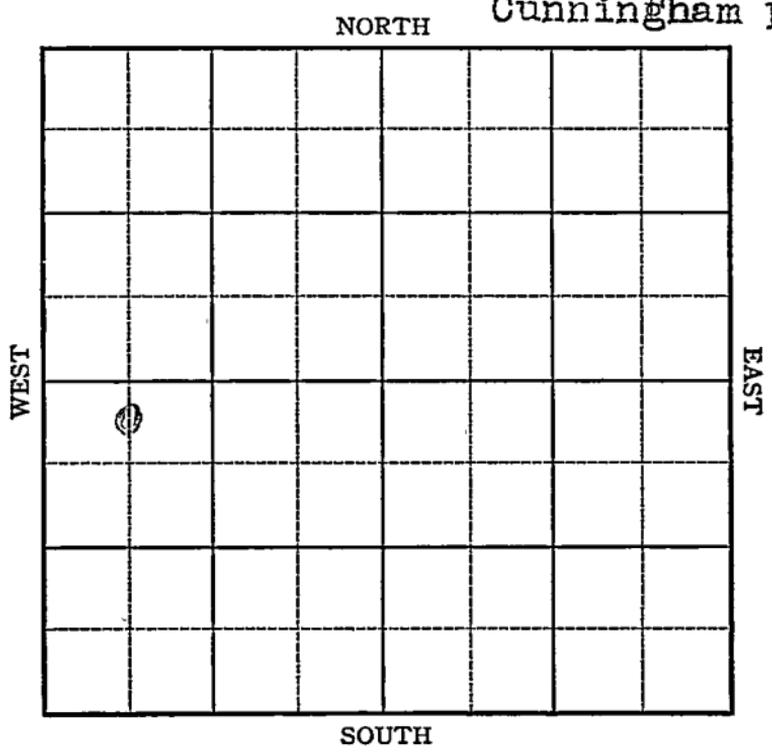

Map No. K-54 Sec. 36 Twp. 27 R. 11W

Well No. 1 McCellan "B"

Gulf Company

Contractor

FIRST REPORT

C NL NW SW


330 Ft. from N. Line

\_\_\_\_\_ Ft. from S. Line

\_\_\_\_\_ Ft. from E. Line

660 Ft. from W. Line

SECTION PLAT

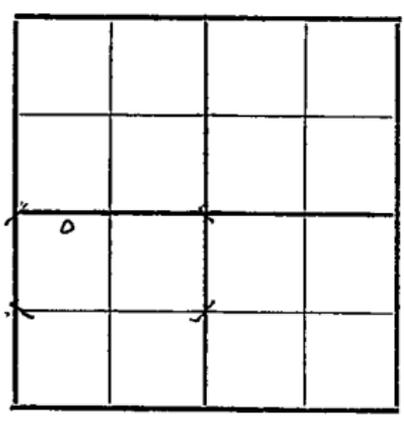

CUNNINGHAM POOL

Location ✓

Rig up \_\_\_\_\_

Drilling and Remarks:

RECORD

Cased \_\_\_\_\_ in., \_\_\_\_\_ ft.

Sand \_\_\_\_\_

Gas \_\_\_\_\_

Oil \_\_\_\_\_

Total Depth \_\_\_\_\_

PRODUCTION

1st 24 hrs. Nat. \_\_\_\_\_

1st 24 hrs. after shot \_\_\_\_\_

Gas \_\_\_\_\_ Cu. Ft.

Dry Hole \_\_\_\_\_

Abandoned \_\_\_\_\_

Date

OCT 1 1941 19

S. J. LEWIS Scout

We show Skelly drilled gas well in C SW/4.  
Don

Misc. Small Maps	<i>[Handwritten initials]</i>
Cards	<i>[Handwritten initials]</i>
Tracing	<i>[Handwritten initials]</i>
France Map	<i>[Handwritten initials]</i>
Scarborough Map	<i>[Handwritten initials]</i>
Moody Map	<i>[Handwritten initials]</i>
Geological Dept.	
Moody Plat Book	

Map No. 54 Sec. 36 Twp. 27 R. 11WWell No. 1 McCellan "B"Gulf

Company

COMPLETED

Contractor

C NL NW SW

330 Ft. from N. Line

Ft. from S. Line

Ft. from E. Line

660 Ft. from W. Line

## SECTION PLAT

o			

CUNNINGHAM POOL

Location \_\_\_\_\_

Rig up \_\_\_\_\_

Drilling and Remarks:

*Loss 3483**8" @ 3465**51' of 7" pipe 3513**15000 acid**Pump 102 oil 64**278 Water 41° G*

## RECORD

Cased \_\_\_\_\_ in., \_\_\_\_\_ ft.

Sand \_\_\_\_\_

Gas \_\_\_\_\_

Oil \_\_\_\_\_

Total Depth 3548

## PRODUCTION

1st 24 hrs. Nat. \_\_\_\_\_

1st 24 hrs. after shot \_\_\_\_\_

Gas \_\_\_\_\_ Cu. Ft.

Dry Hole \_\_\_\_\_

Abandoned \_\_\_\_\_

Date

DEC 3 1941 19S. J. LEWIS Scout

Misc. Small Maps	<i>DM</i>
Cards	<i>DM</i>
Tracing	<i>DM</i>
France Map	<i>DM</i>
Scarborough Map	<i>DM</i>
Moody Map	
Geological Dept.	
Moody Flat Book	