

KANSAS


pratt

FORM 51 5M 4-41 PETROL

Section 36 Township 27 Range 11W

Well No. #4 Miller

Company Skelly oil

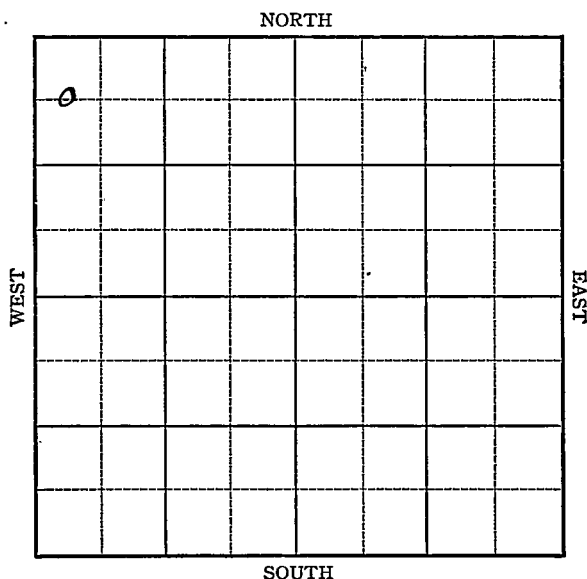

KANSAS


Pratt

Sec. 36 Twp. 27 R. 11-WWell No. #4 Miller FarmSkelly Oil Company

(Cunningham)

660 Ft. from N. Line Ft. from S. Line Ft. from E. Line330 Ft. from W. Line

Elev. 1692

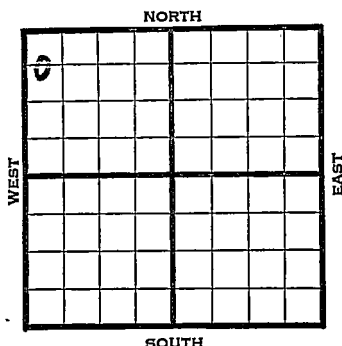

1941

REPORT

6/25

Rotary.

7/3

Drlg. 2010'

7/10

Lans. 3456-60' T.D. 5" - 3459'

RUST.

7/17

Drlg. 3496' S. O.

7/23

Lansing 3456'

5" @ 3459

TD 3520 $\frac{1}{2}$

7000 gals acid

Pump 133 oil & 34% water

34.5 Gravity

COMPLETED

Map No. 54 Sec. 36 Twp. 27 R. 11WWell No. 4 MillerSkelly Oil Company

Contractor

FIRST REPORT

C W L NW NW

660 Ft. from N. Line Ft. from S. Line Ft. from E. Line330 Ft. from W. Line

CUNNINGHAM POOL

SECTION PLAT

o			

Location Rig up

Drilling and Remarks:

Rotary

RECORD

Cased in., ft.Sand Gas Oil Total Depth

PRODUCTION

1st 24 hrs. Nat. 1st 24 hrs. after shot Gas Cu. Ft.Dry Hole Abandoned

Date

JUN 25 1941

19

S. J. LEWIS Scout

Map No. 54 Sec. 36 Twp. 27 R. 11WWell No. 4 MillerSkelly Oil

Company

Contractor

COMPLETED

SECTION PLAT

C^W L NW NW660 Ft. from N. Line

Ft. from S. Line

Ft. from E. Line

330 Ft. from W. Line

0			

CUNNINGHAM POOL

Location

Rig up

Drilling and Remarks:

Loss 8456
 5" @ 3459
 7000 acrol
 Pump 133 oil +
 34 1/2 Water
 34 5/8 Gr

RECORD

Cased _____ in., _____ ft.

Sand

Gas

Oil

Total Depth 3520 1/2

PRODUCTION

1st 24 hrs. Nat.

1st 24 hrs. after shot

Gas _____ Cu. Ft.

Dry Hole

Abandoned

Date

JUL 23 1941

19

S. J. LEWIS

Scout