

# KANSAS


Pratt

FORM 51 5M 4-41 PETROL

Section 36 Township 27 Range 11W

Well No. 5-Miller

Company Skelly Oil

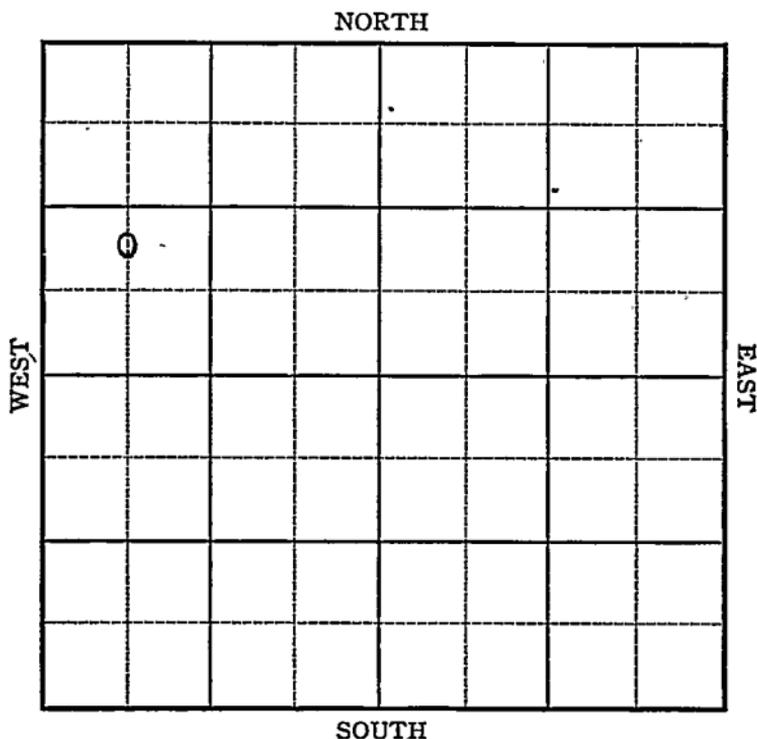

Sec. 36 Twp. 27 R. 11-W

Well No. #5 Miller Farm

Skelly Oil Company


(Cunningham)

\_\_\_\_\_ Ft. from N. Line

990 Ft. from S. Line

\_\_\_\_\_ Ft. from E. Line

660 Ft. from W. Line

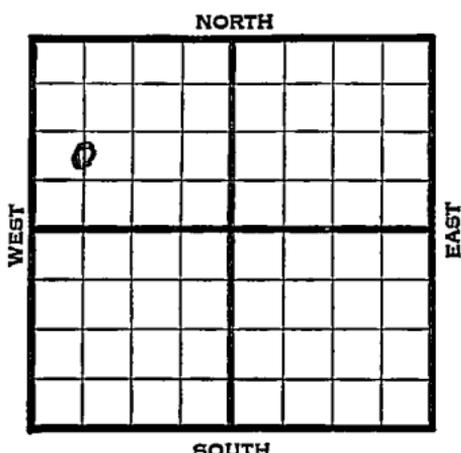

Elev. 1701

1941	REPORT
9/3	Rotary.
9/11	8" - 355' Drlg. 1575'
9/18	Drlg. 3170'
9/25	Lans. 3467' 5" - 3719'
	T.D. 3720' RUST.
10/2	" " "
10/9	12 shots 3512-16'
	24 " 3516-20'
	12 " 3620-24'
	36 " 3473-81'
	24 " 3512-24'
	10,750 acid. Swab 10 oil plus 22% water per hour.
10/15	Lans. 3467'
	5" - 3719'
	T.D. 3720'
	108 shots 3512-3624'
	10,750 acid.
	Potential 243 bbls., pump.
	34.5 Gravity
	<b>COMPLETED</b>

Map No. 54 Sec. 36 Twp. 27 R. 11WWell No. 5 MillerSkelly Oil CompanyFIRST REPORT Contractor

C N L SW NW

\_\_\_\_\_ Ft. from N. Line

990 Ft. from S. Line

\_\_\_\_\_ Ft. from E. Line

660 Ft. from W. Line

CUNNINGHAM POOL

## SECTION PLAT

o			

Location \_\_\_\_\_

Rig up \_\_\_\_\_

Drilling and Remarks:

Rotary

## RECORD

Cased \_\_\_\_\_ in., \_\_\_\_\_ ft.

Sand \_\_\_\_\_

Gas \_\_\_\_\_

Oil \_\_\_\_\_

Total Depth \_\_\_\_\_

## PRODUCTION

1st 24 hrs. Nat. \_\_\_\_\_

1st 24 hrs. after shot \_\_\_\_\_

Gas \_\_\_\_\_ Cu. Ft.

Dry Hole \_\_\_\_\_

Abandoned \_\_\_\_\_

Date

SEP 3 1941 19S. J. LEWIS Scout

