

Section 36 Township 27 Range 11WWell No. 6 MillerCompany Skelly

Cunningham

NORTH

			o				

WEST

EAST

SOUTH

KANSAS

Pratt



Sec. 36 Twp. 27 R. 11W

Well No. #6 Miller Farm

Skelly Company

Cunningham Pool


 Ft. from N. Line

990' Ft. from S. Line

330' Ft. from E. Line

 Ft. from W. Line

NE SE NW

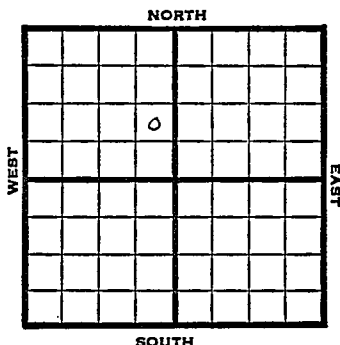

1949

Elev 1693'

R E P O R T

3/2

8" @ 340'

Drlg. 1700'

3/8

Drlg 2815'

3/16

Douglas 3370'

Lansing 3465'

5" @ 3471'

TD

3/23

TD 3535'

4000 acid

3/30

TD 3555'

4000 acid

Swb 5 bbls oil & 92 W 24 hrs.

4/6

TD 3555'

Lans. 3465'

5"@ 3471'

Aband.

ABANDONED

Map No. _____ Sec. 36 Twp. 27 R. 11W

Well No. 6 Miller

Skelly Company

FIRST REPORT

Contractor _____

NE SE NW


SECTION PLAT

_____ Ft. from N. Line

990 Ft. from S. Line

330 Ft. from E. Line

_____ Ft. from W. Line

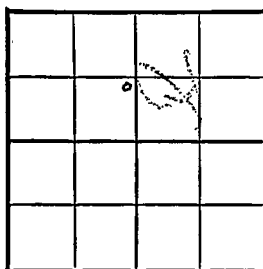

Pratt County

Location _____

Rig up _____

Drilling and Remarks:

8" @ 340

drlg. 1700

RECORD

Cased _____ in., _____ ft.

Sand _____

Gas _____

Oil _____

Total Depth _____

PRODUCTION

1st 24 hrs. Nat. _____

1st 24 hrs. after shot _____

Gas _____ Cu. Ft.

Dry Hole _____

Abandoned _____

Date

MAR 2 1949

19

S. J. LEWIS

Scout

Map No. 54 Sec. 36 Twp. 27 R. 11W

Well No. 6 Miller

Skelly Company

ABANDONED

Contractor

NE SE NW

E. 1623
SECTION PLAT

 Ft. from N. Line

990 Ft. from S. Line

330 Ft. from E. Line

 Ft. from W. Line

	6		

Pratt County

Location

Rig up

Drilling and Remarks:

Loss 3465
5" @ 2471

RECORD

Cased in., ft.

Sand

Gas

Oil

Total Depth 3555

PRODUCTION

1st 24 hrs. Nat.

1st 24 hrs. after shot

Gas Cu. Ft.

Dry Hole

Abandoned

Date

APR 6 1949 19

S. J. LEWIS Scout