Form 51—5M—11-38—Palace


KANSAS

Pratt

Section 36 Township 27 Range 11-W

Well No. #1 G. D. Miller

Company Skelly

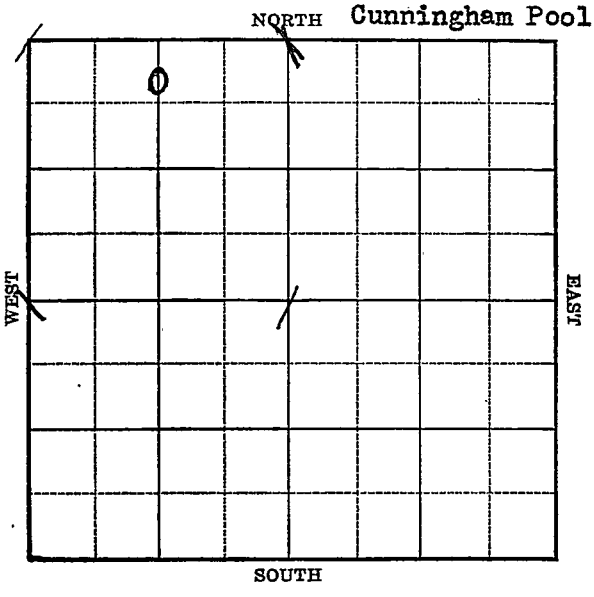

FORM 252-A 5M 10-38 **KANSAS** Pratt

Sec. 36 Twp. 27 R. 11-W

Well No. #1 C. D. Miller Farm

Skelly Company


(Cunningham)

440 Ft. from N. Line

Ft. from S. Line

Ft. from E. Line

1320 Ft. from W. Line

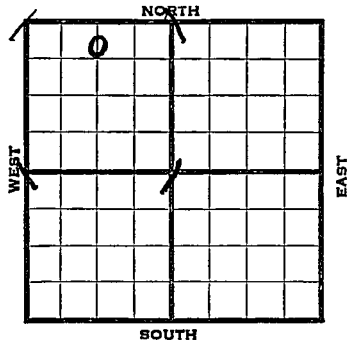

Elev. 1687

1938	REPORT
12/28	Rot. Mat'l.
1939	
1/6	13" - 363'. WOC.
1/13	Drlg. 2160'.
1/20	Drlg. 3225'.
1/27	Lans. 3448-52' S.O.
	7" - 3450'. RUST.
2/1	7" - 3450'.
	Lans. 3448'.
	T. D. 3501'.
	4000 acid.
	Flow 97½ oil & 17 water 8 hrs.
	Potential 293 bbls.
	1 M gas.
	COMPLETED

Form 26—1M Bks.—2-29

Pratt KANSAS

Map No. 54 Sec. 36 Twp. 27 R. 11W

Well No. 1 G. D. Miller

Skelly Company

Contractor

FIRST REPORT

C N L NW

440 Ft. from N. Line


Ft. from S. Line

Ft. from E. Line

1320 Ft. from W. Line

CUNNINGHAM POOL

SECTION PLAT

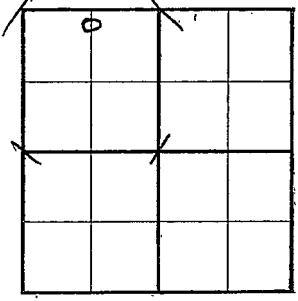

Location

Rig up

Drilling and Remarks:

ROT MATL.

RECORD

Cased in., ft.

Sand

Gas

Oil

Total Depth

PRODUCTION

1st 24 hrs. Nat.

1st 24 hrs. after shot

Gas Cu. Ft.

Dry Hole

Abandoned

Date

DEC 28 1938 19

H. D. Hatfield Scout

Form 26—1M Bks.—2-29

Pratt KANSAS

Map No. 54 Sec. 36 Twp. 27 R. 11W

Well No. 1 G. D. Miller

Skelly Company

Contractor

COMPLETED

C N L NW

440 Ft. from N. Line


Ft. from S. Line

Ft. from E. Line

1320 Ft. from W. Line

CUNNINGHAM POOL

SECTION PLAT

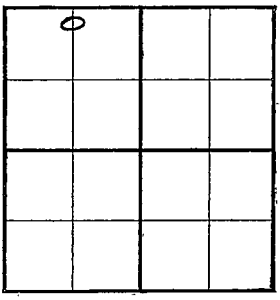

Location

Rig up

Drilling and Remarks:

4000 Acid

Flow 92½ oil
12 wtr/8 hrs

Pot 293
1-M gas

RECORD

Cased 7 in., 3450 ft.

Sand- LANS 3448

Gas

Oil

Total Depth 3501

PRODUCTION

1st 24 hrs. Nat.

1st 24 hrs. after shot

Gas Cu. Ft.

Dry Hole

Abandoned

Date

FEB 1 - 1939 19

H. D. Hatfield Scout