

# KANSAS

Form 51-5M-7-39-Palace


Pratt

Section 36 Township 27 Range 11-W

Well No. #2 Miller

Company Skelly

NORTH **Cunningham Pool**

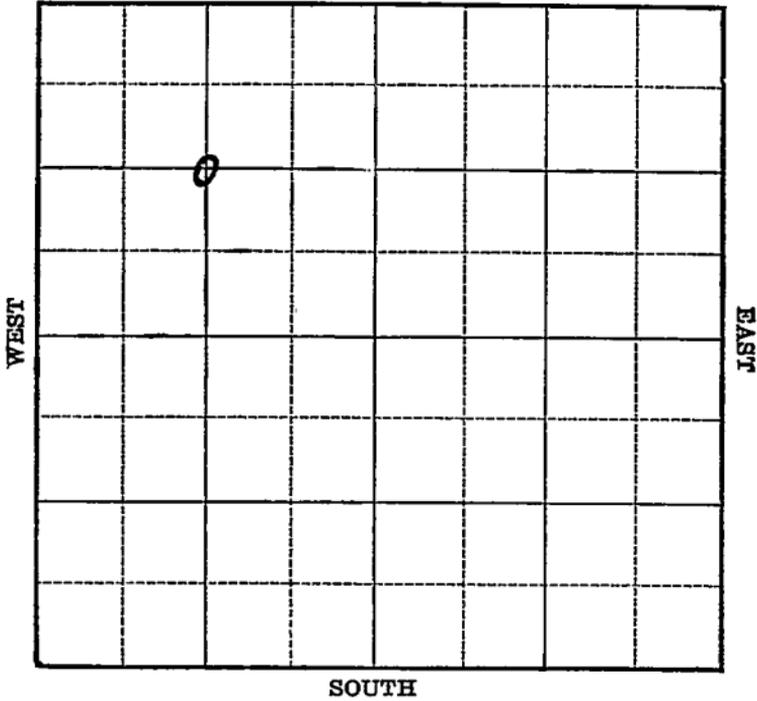

Sec. 36 Twp. 27 R. 11-W

Well No. #2 Miller Farm \_\_\_\_\_

Skelly Company \_\_\_\_\_

(Cunningham)


1320 Ft. from N. Line

\_\_\_\_\_ Ft. from S. Line

1325 Ft. from E. Line

\_\_\_\_\_ Ft. from W. Line

Elev. 1693

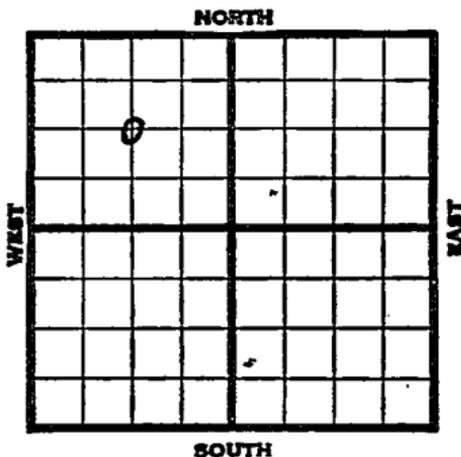

| 1940 | REPORT                             |
|------|------------------------------------|
| 3/6  | Bldg. rotary rig.                  |
| 3/14 | 10" - 375' WOC.                    |
| 3/21 | Drlg. 2600'                        |
| 3/28 | Lans. 3458' Drlg. 3725'            |
| 4/4  | Kinderhook 4021' Viola 4085-89     |
|      | T.D. 4089' 5" - 4085' RUST.        |
| 4/12 | T.D. 4105' 9 M cu. ft. gas.        |
|      | 1000 acid. 62,400,000 cu. ft. gas. |
| 4/18 | " " " "                            |
| 4/26 | " " " "                            |
|      |                                    |
| 5/1  | Viola 4085'                        |
|      | 5" - 4087'                         |
|      | T.D. 4105'                         |
|      | 1000 acid.                         |
|      | 60 M cu. ft. gas.                  |
|      | <b>COMPLETED</b>                   |

Map No. 54 Sec. 36 Twp. 27 R. 11WWell No. 2 MillerSkelly

Company

Contractor

## FIRST REPORT

C NW

1320 Ft. from N. Line


\_\_\_\_\_ Ft. from S. Line

1325 Ft. from E. Line

\_\_\_\_\_ Ft. from W. Line

Cunningham Pool

## SECTION PLAT

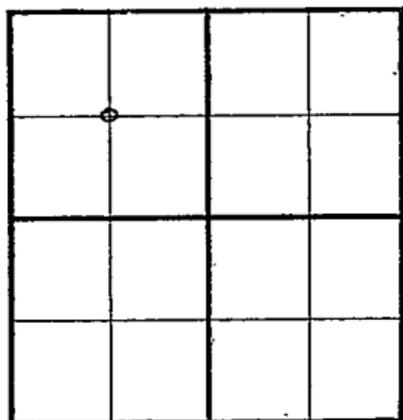

Location \_\_\_\_\_

Rig up \_\_\_\_\_

Drilling and Remarks:

Bldg. Roty Rig

## RECORD

Cased \_\_\_\_\_ in., \_\_\_\_\_ ft.

Sand \_\_\_\_\_

Gas \_\_\_\_\_

Oil \_\_\_\_\_

Total Depth \_\_\_\_\_

## PRODUCTION

1st 24 hrs. Nat. \_\_\_\_\_

1st 24 hrs. after shot \_\_\_\_\_

Gas \_\_\_\_\_ Cu. Ft.

Dry Hole \_\_\_\_\_

Abandoned \_\_\_\_\_

Date

MAR 6 1940

19

S. J. LEWIS

Scout

Map No. 54 Sec. 36 Twp. 27 R. 11W

Well No. 2 Miller

Skelly Company

Contractor

**COMPLETED**

C NW

**SECTION PLAT**

|  |   |  |  |
|--|---|--|--|
|  |   |  |  |
|  | o |  |  |
|  |   |  |  |
|  |   |  |  |

1320 Ft. from N. Line

\_\_\_\_\_ Ft. from S. Line

1325 Ft. from E. Line

\_\_\_\_\_ Ft. from W. Line

**CUNNINGHAM POOL**

Location \_\_\_\_\_

**RECORD**

Cased \_\_\_\_\_ in., \_\_\_\_\_ ft.

Sand \_\_\_\_\_

Gas \_\_\_\_\_

Oil \_\_\_\_\_

Total Depth 410.5

Rig up \_\_\_\_\_

Drilling and Remarks:

*Vidla 4085*

*5" C 4087*

*1000 acid*

*60 M Gas*

**PRODUCTION**

1st 24 hrs. Nat. \_\_\_\_\_

1st 24 hrs. after shot \_\_\_\_\_

Gas \_\_\_\_\_ Cu. Ft.

Dry Hole \_\_\_\_\_

Abandoned \_\_\_\_\_

Date

MAY 1 1919

S. J. LEWIS Scout