

KANSAS

Form 51-5M-7-39-Palace


Pratt **O. W. P. B.**

Section 36 Township 27 Range 11-W

Well No. #1 Steffens "B"

Company Skelly ^{Oil} et al

NORTH **Cunningham Pool**

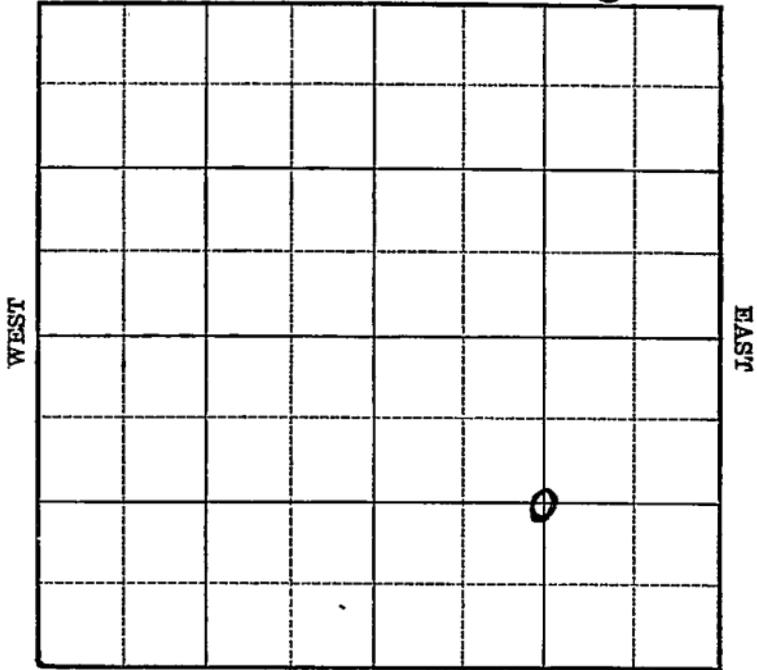

SOUTH

Sec. 36 Twp. 27 R. 11-W ✓

Well No. #1 Steffens "B" Farm

Skelly et al Company

(Cunningham)

~~1320~~
~~1325~~ Ft. from N. Line


Ft. from S. Line

~~1320~~
~~1328~~ Ft. from E. Line

Ft. from W. Line

C SE/4

Elev. 1707

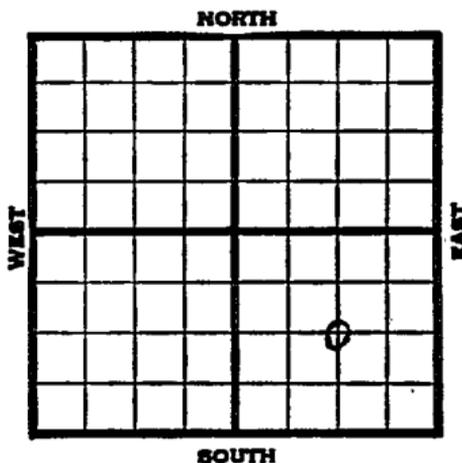

1939	REPORT
9/13	Rotary.
9/21	10" - 375' Drlg. 1640'
9/28	Drlg. 2750'
10/5	Lans. 3482' Drlg. 3800'
10/12	Kinderhook 4038' Viola 4106½'
	T.D. 4106' RUST. 5" - 4106½'
10/18	Misener 4038'
	5" - 4106½'
	Viola 4106'
	T.D. 4124'
	1000 acid.
	86,807,000 cu. ft. gas.
	1360# rock pressure.
	COMPLETED
	OVER

O. W. P. B.

1953

10/21

Oil Well

TD 4124'

KC 3482

Viola 4106'

5" @ 4106

OTD 4124

PB 3690

20/3674-79

P/1 bo 13 bw 7 hrs.

PB 3509

36/3490-96 500A

P/18 bo 2 bw 24 hrs., 1500A

Comp. 21 bopd 2 bw

FIRST REPORT

+

COMPLETED

Pratt

KANSAS

Map No. 54 Sec. 36 Twp. 27 R. 11WWell No. 1 Steffens "B"Skelly et al

Company

Contractor

FIRST REPORT

C SE

1325 Ft. from N. Line


_____ Ft. from S. Line

1328 Ft. from E. Line

_____ Ft. from W. Line

CUNNINGHAM POOL

SECTION PLAT

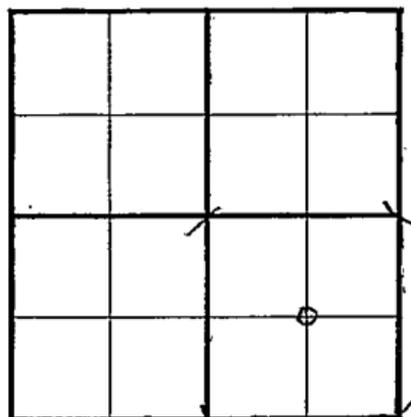

Location _____

Rig up _____

Drilling and Remarks:

. Rotary

RECORD

Cased _____ in., _____ ft.

Sand _____

Gas _____

Oil _____

Total Depth _____

PRODUCTION

1st 24 hrs. Nat. _____

1st 24 hrs. after shot _____

Gas _____ Cu. Ft.

Dry Hole _____


Abandoned _____

Date

SEP 13 1939

S. J. LEWIS

Scout

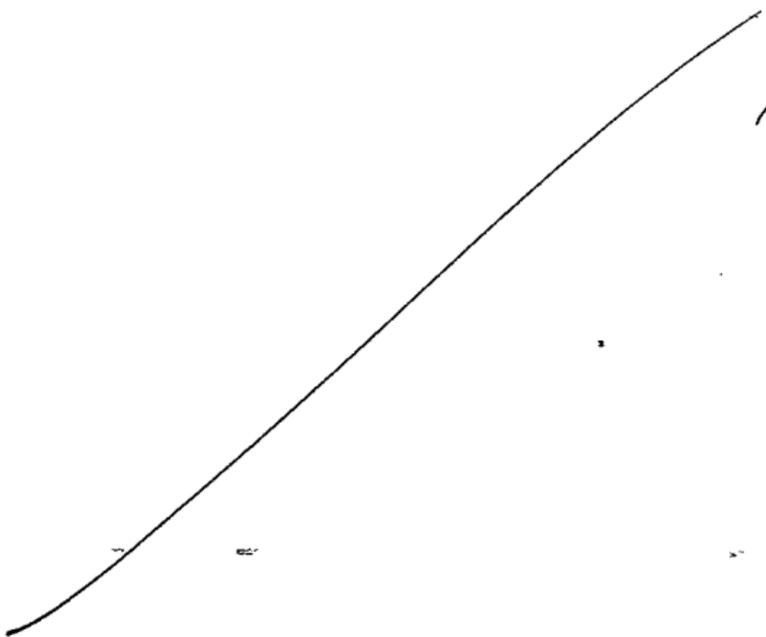

Misc Small Maps	<i>RAM</i>
Cards	<i>RAM</i>
Tracing	<i>RAM</i>
France Map	<i>RAM</i>
Scarborough Map	<i>RAM</i>
Moody Map	<i>RAM</i>
Ceological Dept.	
Moody Flat Book	

Map No. 54 Sec. 36 Twp. 27 R. 11WWell No. 1 Steffens "B"Skelly etal

Company

Contractor

COMPLETED

C SE

1325 Ft. from N. Line


_____ Ft. from S. Line

1328 Ft. from E. Line

_____ Ft. from W. Line

GUNNINGHAM POOL

SECTION PLAT

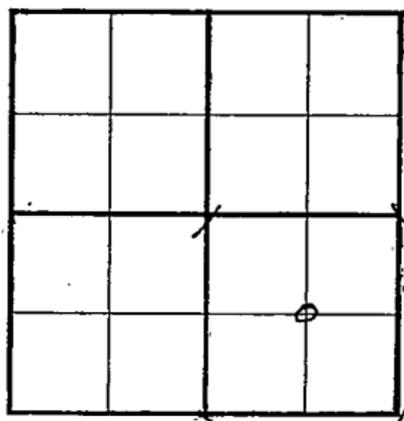

Location _____

Rig up _____

Drilling and Remarks:

Miscellaneous 4038.
5" @ 4106 1/2.
Vista 4106
1000 acid
86,807,000 Gas.
1360 Rock Pt

RECORD

Cased _____ in., _____ ft.

Sand _____

Gas _____

Oil _____

Total Depth 4124

PRODUCTION

1st 24 hrs. Nat. _____

1st 24 hrs. after shot _____

Gas _____ Cu. Ft.

Dry Hole _____

Abandoned _____

Date

OCT 18 1930 19S. J. LEWIS Scout

See Small
Date

RAY
RAY
RAY

O. W. P. B.

County Pratt State Kansas

Sec. 36 (Blk. Twp.) 27 (Sur. Rge.) 11W Map No.

Operator Skelly Oil

Well No. 1 Farm Steffen "B"

Elev. 1707 Location C SE/4

FIRST REPORT					
COMPLETE					

1320 Ft. From S Line SE

1320 Ft. From E Line Quarter

Ist. Report OCT 21 1953

Completion OCT 21 1953

Remarks OWPB

O. W. P. B.

Spudding Date

Drlg. Data Oil well TD 4124

KC 3482 Viola 4106 5" @ 4106 OTD 4124

PB 3690 20/ 3674-79 P/ 1 bo 13 bw 7 hr

PB 3509 36/ 3490-96 500 A P/ 18 bo

2 bw 24 hr. 1500 A Comp. 21 bopd 2 bw

Scout Cards	10
Land Small Map	3
Land Wall Map	
Tracing	
France Map	
Pierce Map	
Misc.	

OCT 23 1963