

STATE CORPORATION COMMISSION OF KANSAS
OIL & GAS CONSERVATION DIVISION
WELL COMPLETION OR RECOMPLETION FORM
ACO-1 WELL HISTORY
DESCRIPTION OF WELL AND LEASE

Operator: License # 5398
Name .. ARCO OIL AND GAS COMPANY
Address .. Box 1610
City/State/Zip .. Midland, Texas .. 79702

Purchaser .. ARCO OIL AND GAS COMPANY

Operator Contact Person .. Ken W. Gasnell
Phone .. 915/688-5672

Contractor: License # 03098
Name .. Exeter Drilling Co.

Wellsite Geologist
Phone

Designate Type of Completion

☒ New Well ☐ Re-Entry ☐ Workover
☐ Oil ☐ SWD ☐ Temp Abd
☒ Gas ☐ Inj ☐ Delayed Comp.
☐ Dry ☐ Other (Core, Water Supply etc.)

If **OWG**: old well Info as follows:

Operator
Well Name
Comp. Date .. Old Total Depth

WELL HISTORY

Drilling Method:

☒ Mud Rotary ☐ Air Rotary ☐ Cable

10-7-88 10-10-88 10-22-88
Spud Date Date Reached TD Completion Date

2800 2751
Total Depth PBTD

Amount of Surface Pipe Set and Cemented at 702 feet
Multiple Stage Cementing Collar Used? ☐ Yes ☒ No
If yes, show depth set feet
If alternate 2 completion, cement circulated
from feet depth to w/ SX cmt
Cement Company Name
Invoice #

API NO. 15-067-20823

County.. Grant

SE NW NW Sec. 16 Twp. 27 Rge. 38 East
X West

4040 Ft North from Southeast Corner of Section
4017 Ft West from Southeast Corner of Section

(Note: Locate well in section plat below)


Lease Name.. W. N. Ackerman Unit Well # 3

Field Name.. Hugoton

Producing Formation.. Chase

Elevation: Ground 3156 KB 3166

Section Plat

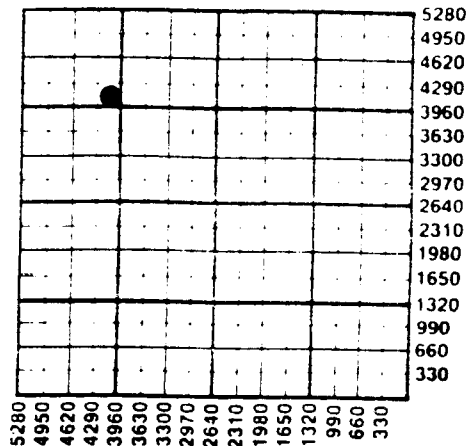

WATER SUPPLY INFORMATION

Disposition of Produced Water: ☐ Disposal
Docket # ☐ Repressuring

Questions on this portion of the ACO-1 call:

Water Resources Board (913) 296-3717

Source of Water:
Division of Water Resources Permit # T88-459

☒ Groundwater 5100 Ft North from Southeast Corner
(Well) 5160 Ft West from Southeast Corner of
Sec 27 Twp 27 Rge 38 East X West

☐ Surface Water Ft North from Southeast Corner
(Stream, pond etc) Ft West from Southeast Corner
Sec Twp Rge East West

☐ Other (explain)
(purchased from city, R.W.O. #)

INSTRUCTIONS: This form shall be completed in triplicate and filed with the Kansas Corporation Commission, 200 Colorado Derby Building, Wichita, Kansas 67202, within 120 days of the spud date of any well. Rule 82-3-130, 82-3-107 and 82-3-106 apply.

Information on side two of this form will be held confidential for a period of 12 months if requested in writing and submitted with the form. See rule 82-3-107 for confidentiality in excess of 12 months. One copy of all wireline logs and drillers time log shall be attached with this form. Submit CP-4 form with all plugged wells. Submit CP-111 form with all temporarily abandoned wells.

All requirements of the statutes, rules and regulations promulgated to regulate the oil and gas industry have been fully complied with and the statements herein are complete and correct to the best of my knowledge.

Signature .. Ken W. Gasnell

Title .. Engr. Tech. Survey Date .. 1-27-89
KANSAS SURVEYOR
WICHITA BRANCH

Subscribed and sworn to before me .. day of .. January .. 1989

Notary Public .. Lisa A. Gordy

Date Commission Expires .. 6-6-92

LISA A. GORDY

Notary Public, State of Texas

My Comm. Expires: 6-6-92

K.C.C. OFFICE USE ONLY

☒ Letter of Confidentiality Attached
☒ Wireline Log Received
☐ Drillers Timelog Received

Distribution

☒ KCC ☐ SWD/Rep ☐ NGPA
☒ KGS ☐ Plug ☐ Other
(Specify)