

KANSAS

Grant


Section 4 Township 27 Range 38W

Well No. 1 Wright "B"

Company Western Natural Gas

Hugoton

NORTH

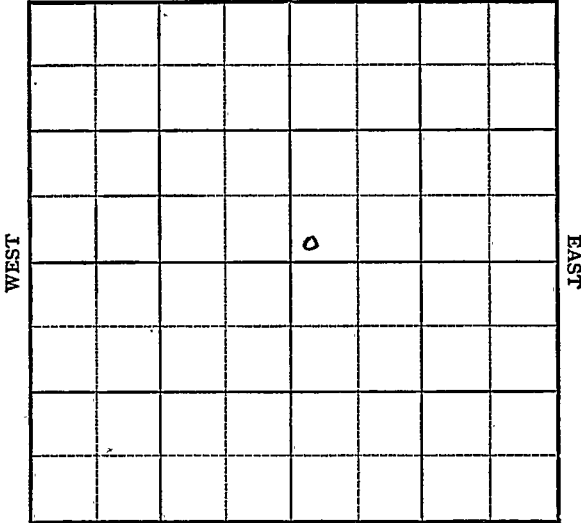

SOUTH

Sec. 4 Twp. 27 R. 38W ✓

Well No. #1 Wright "B" Farm

Western Natural Gas Company


Hugoton Pool (Burris, Cont.) NORTH

_____ Ft. from N. Line

150' Ft. from S. Line

_____ Ft. from E. Line

150' Ft. from W. Line

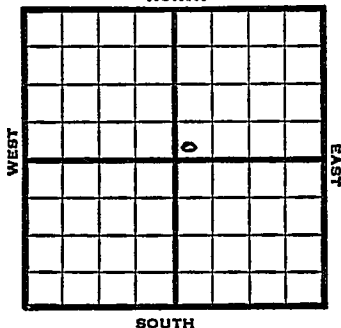

SW NE

SOUTH

1949

Elev. 3178' REPORT

5/18 Location

5/25 10" @ 606'

Drlg. 1400'

6/1 TD 2375'

7" @ 2367'

6/7 Drlg 2521'

6/15 "

6/22 7" @ 2367'

255' of 5" Perf liner @ 2640'

Acid 17,000

Gas 24,356,000

R. Pr. 425#

TD 2640'

COMPLETED

Kansas

Map No. _____ Sec. 4 Twp. 27 R. 38W

Well No. 1 Wright "B"

Western Natural Gas Company

Burriss Contractor

SW NE

**FIRST REPORT
SECTION PLAT**

_____ Ft. from N. Line

150 Ft. from S. Line

_____ Ft. from E. Line

150 Ft. from W. Line

Grant County

Location X

Rig up _____

Drilling and Remarks:

RECORD

Cased _____ in., _____ ft.

Sand _____

Gas _____

Oil _____

Total Depth _____

PRODUCTION

1st 24 hrs. Nat. _____

1st 24 hrs. after shot _____

Gas _____ Cu. Ft.

Dry Hole _____

Abandoned _____

Date

MAY 18 1949 19

S. J. LEWIS

Scout

