


Section 4 Township 27 Range 35W

Well No. #1 Dew

Company Magnolia
Hugoton Pool

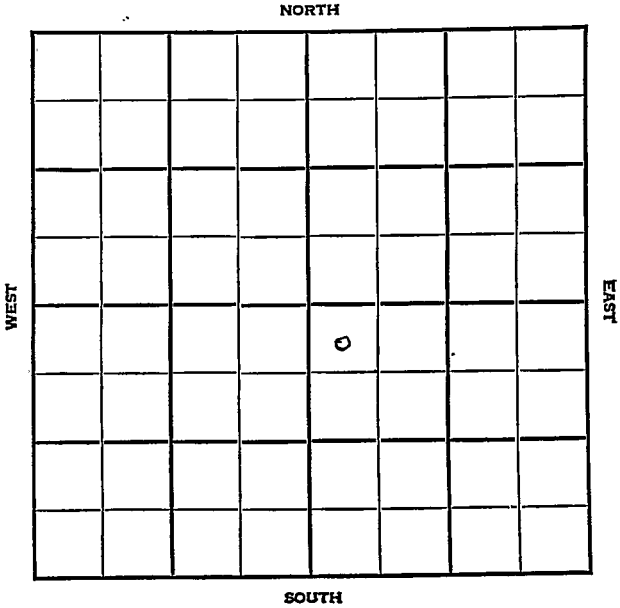

KANSAS

Grant



Sec. 4 Twp. 27 R. 35W

Well No. #1 Dew Farm

Magnolia Company

Hugoton Pool


330' Ft. from N. Line

_____ Ft. from S. Line

_____ Ft. from E. Line

330' Ft. from W. Line

NW SE

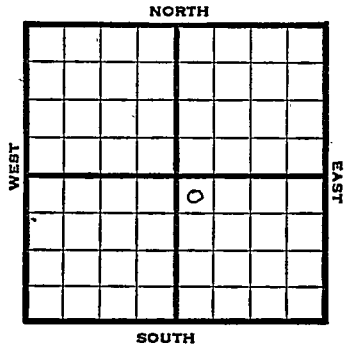

1948	Elev. 3044' REPORT
3/27	Location
3/31	"
4/7	"
4/14	10" @ 805' Drlg. 850'
4/21	Drlg. 2776'
4/28	TD 2805' 7" @ 2805' 180 shots 2716-43' 7000 acid.
5/5	48 shots 2620-32 7000 Acid
5/12	72 shots 2578-96' - 7000 acid.
5/19	"
6/1	7" @ 2805' Perf. Acid 21,000 Gas 14 M R. Pr. 400# TD 2805'
COMPLETED	

Map No. _____ Sec. 4 Twp. 27 R. .35W

Well No. 1 Dew

Magnolia _____ Company

FIRST REPORT _____ Contractor

NW SE

SECTION PLAT

330 Ft. from N. Line

_____ Ft. from S. Line

_____ Ft. from E. Line

330 Ft. from W. Line

		o	

Grant County

Location X

Rig up _____

Drilling and Remarks:

RECORD

Cased _____ in., _____ ft.

Sand _____

Gas _____

Oil _____

Total Depth _____

PRODUCTION

1st 24 hrs. Nat. _____

1st 24 hrs. after shot _____

Gas _____ Cu. Ft.

Dry Hole _____

Abandoned _____

Date

MAR 24 1948 19 _____ S. J. LEWIS Scout

Map No. _____ Sec. 4 Twp. 27 R. 35W

Well No. 1 Dew

Magnolia _____ Company

COMPLETE

Contractor

NW SE

E. 1,3044

SECTION PLAT

		o	.

330 Ft. from N. Line

_____ Ft. from S. Line

_____ Ft. from E. Line

330 Ft. from W. Line

Grant County

Location _____

Rig up _____

Drilling and Remarks:

7" C 2805

Perf.

21000 gals

14 1/2 Gals

400 # R/B

RECORD

Cased _____ in., _____ ft.

Sand _____

Gas _____

Oil _____

Total Depth 2805

PRODUCTION

1st 24 hrs. Nat. _____

1st 24 hrs. after shot _____

Gas _____ Cu. Ft.

Dry Hole _____

Abandoned _____

Date

JUN 1 1948 19

S. J. LEWIS Scout