


Section 4 Township 27 Range 39W

Well No. #1 Trussell Gas Unit "B"

Company Stanolind

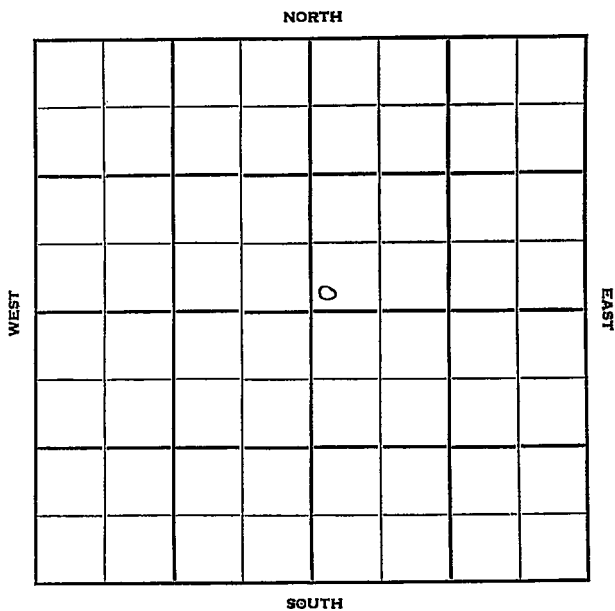

Sec. 4 Twp. 27 R. 39W

Well No. #1 Trussell Gas Unit "B" Farm

Stanolind

Company

Hugoton Pool

Contractor

Ft. from N. Line

150


Ft. from S. Line

Ft. from E. Line

150

Ft. from W. Line

SW NE

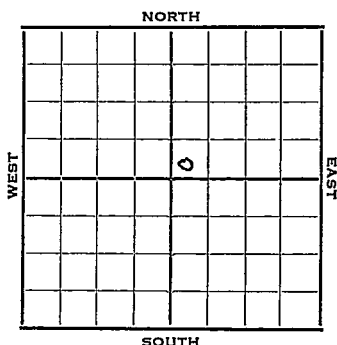

1952

Elev. 3263'

REPORT

7/30

Location

8/6

"

8/13

"

8/20

"

8/27

10" @ 590'

Drlg. 2290'

9/3

Her 2372 Winfield 2430

Towanda 2493 Ft. Riley 2548

5" @ 2548 RTD 2580

CO 2580 2500A

78/2373-86 24/2389-93

42/2397-2404 48/2409-17

66/2431-42 36/2444-50

66/2456-65 90/2493-2508

48/2512-20 42/2525-32

9/10

Spud 8-19-52 Gas Well TD 2580

10" @ 590'

Her. 2372 Win. 2430

Tow. 2493 Ft. Riley 2548

5" @ 2548 TD 2580

78/ 2373-86 24/ 2389-93

42/ 2397-2404 48/ 2409-17

66/ 2431-42 36/ 2444-50

66/ 2456-65 90/ 2493-2508

48/ 2512-30 42/ 2525-32

32000 A

Comp. 12,802,000 gas

**COMPLETED**



