

KANSAS

Grant

Section 5 Township 27 Range 38W

Well No. 1 Wright "A"

Company Western Natural Gas

Hugoton

NORTH

			0				

WEST

EAST

SOUTH

Sec. 5 Twp. 27 R. 38W ✓

Well No. #1 Wright "A" Farm _____

Western Natural Gas Company


Hugoton Pool (Moran., Cont.) NORTH

150' Ft. from N. Line

_____ Ft. from S. Line

150' Ft. from E. Line

_____ Ft. from W. Line

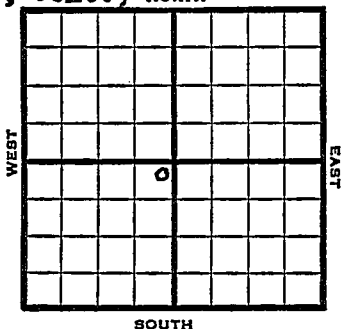

NE SW

1949 Elev. 3183' REPORT

5/18 Surface Hole
10" @ 597'
Drlg 2500'

5/25 TD 2378'
7" @ 2377'

6/1 TD 2582'
293' of 5" Perf liner @ 2582'
Acid 17,000

6/7 "

6/15 "

6/22 7" @ 2377'
293' of 5" Perf liner @ 2582'
Acid 17,000
Gas 10,500,000
R. Pr. 525#
TD 2582'

COMPLETED

No. _____ Sec. 5 Twp. 27 R. 38W

No. 1 Wright "A"

Western Natural Gas Company

CORRECTION

Contractor _____

NE SW

SECTION PLAT

150 Ft. from N. Line

_____ Ft. from S. Line

150 Ft. from E. Line

_____ Ft. from W. Line

Grant County

Location _____

Rig up _____

Drilling and Remarks:

Reported in
Finney County

RECORD

Cased _____ in. _____ ft.

Sand _____

Gas _____

Oil _____

Total Depth _____

PRODUCTION

1st 24 hrs. Nat. _____

1st 24 hrs. after shot _____

Gas _____ Cu. Ft.

Dry Hole _____

Abandoned _____

Date

MAY 18 1949 19

S. J. LEWIS Scout

Kansas

Map No. _____ Sec. 5 Twp. 27 R. 38WWell No. 1 Wright "A"

Western Natural Gas _____ Company

Moran _____ Contractor

NE SW

FIRST REPORT
SECTION PLAT150 Ft. from N. Line

_____ Ft. from S. Line

150 Ft. from E. Line

_____ Ft. from W. Line

Finney County

Location _____

Rig up _____

Drilling and Remarks:

surface hole

RECORD

Cased _____ in., _____ ft.

Sand _____

Gas _____

Oil _____

Total Depth _____

PRODUCTION.

1st 24 hrs. Nat. _____

1st 24 hrs. after shot _____

Gas _____ Cu. Ft.

Dry Hole _____

Abandoned _____

Date

MAY 11 1949 19S. J. LEWIS Scout

Map No. ✓ Kansas Sec. 5 Twp. 27 R. 38W

Well No. 1 Wright "A"

Western Natural Gas Company

COMPLETE

Contractor

NE SW


E 1,318
SECTION PLAT

150 Ft. from N. Line

 Ft. from S. Line

150 Ft. from E. Line

 Ft. from W. Line

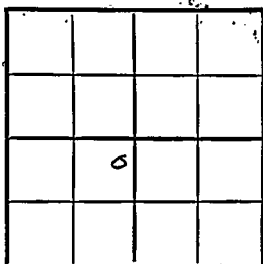

Grant County

RECORD

Location

Cased in., ft.

Rig up

Sand

Drilling and Remarks:

Gas

Oil

Total Depth 2582

PRODUCTION

1st 24 hrs. Nat.

1st 24 hrs. after shot

Gas Cu. Ft.

Dry Hole

Abandoned

7" @ 2377
292' of 5" Perf. line
@ 2582
17000 cu. ft.
10,500,000 Gas
*5.25 * R/R*

Date

JUN 22 1949 19

S. J. LEWIS Scout