


Section 5 Township 27 Range 36W

Well No. #1 Jarvis

Company Osborn et al

Hugoton Pool

NORTH

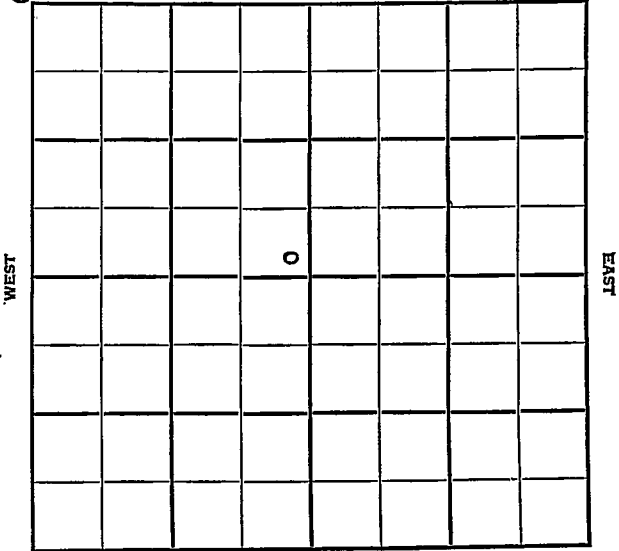

SOUTH

KANSAS Grant



Sec. 5 Twp. 27 R. 36W

Well No. #1 Jarvis Farm

Osborn et al Company

Hugoton


 Ft. from N. Line

100 Ft. from S. Line

100 Ft. from E. Line

 Ft. from W. Line

SE NW

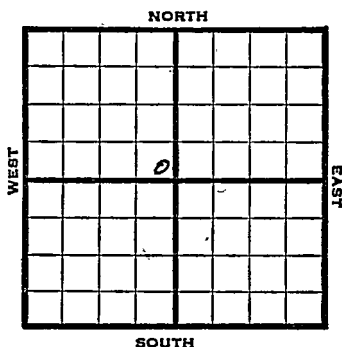

1947 Elev. 3107' REPORT

10/15	9" @ 701' Drlg. 2330'
10/22	7" @ 2734 TD 2750'
10/29	"
11/5	"
11/12	216 shots 2504-40' 108 shots 2564-82' 144 shots 2616-40' 180 shots 2662-92' - 54000 acid.
11/19	"
11/25	"
12/3	"
12/10	7" @ 2734' Perf. 54000 acid 30,418,000 Gas 405# R. Pr. TD 2750'

COMPLETED

Map No. _____ Sec. 5 Twp. 27 R. 36W

Well No. 1 Jarvis

Osborn etal. Company

FIRST REPORT Contractor

SE NW


SECTION PLAT

_____ Ft. from N. Line

100 Ft. from S. Line

100 Ft. from E. Line

_____ Ft. from W. Line

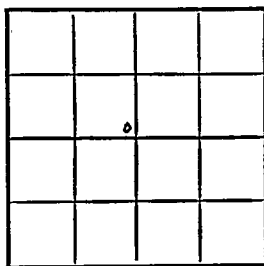

Grant County

Location _____

Rig up _____

Drilling and Remarks:

9" @ 701

drlg. 2330

RECORD

Cased _____ in., _____ ft.

Sand _____

Gas _____

Oil _____

Total Depth _____

PRODUCTION

1st 24 hrs. Nat. _____

1st 24 hrs. after shot _____

Gas _____ Cu. Ft.

Dry Hole _____

Abandoned _____

Date

OCT 15 1947 19. S. J. LEWIS Scout

Kansas

Map No. _____ Sec. 5 Twp. 27 R. 36WWell No. 1 Jarvis

Osborn et al.

Company

COMPLETE

Contractor


SE NW

E13107
SECTION PLAT

_____ Ft. from N. Line

100 Ft. from S. Line100 Ft. from E. Line

_____ Ft. from W. Line

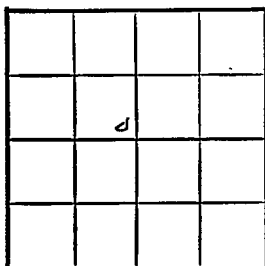

Grant County

RECORD

Location _____

Cased _____ in., _____ ft.

Rig up _____

Sand _____

Drilling and Remarks:

Gas _____

Oil _____

Total Depth 2750

PRODUCTION

1st 24 hrs. Nat. _____

1st 24 hrs. after shot _____

Gas _____ Cu. Ft.

Dry Hole _____

Abandoned _____

Date

DEC 1 0 1947 19

S. J. LEWIS

Scout