


KANSAS

Section 5 Township 27S Range 35W

Well No. #1-C. Dew "B"

Company Magnolia

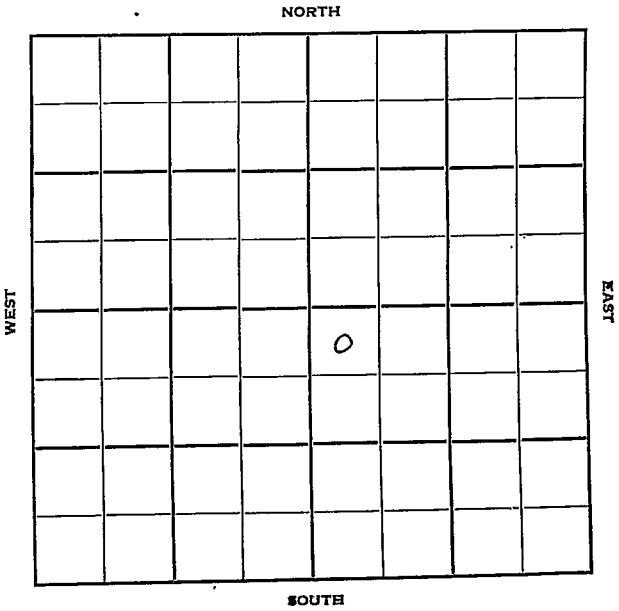

6

KANSAS

Grant

Sec. 5 Twp. 27 R. 35-1/2 ✓

Well No. #1 G Dew "B" Farm _____

Magnolia Company _____

Cont/— Barnett Drlg


Hugoton

330 Ft. from N. Line

_____ Ft. from S. Line

_____ Ft. from E. Line

330 Ft. from W. Line

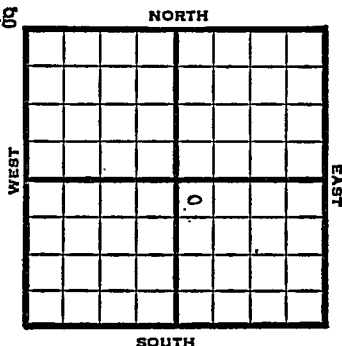

NW SE

1949 Elev 3054' REPORT

10/12 10" @ 812'
Drlg 2850'

10/19 TD 2775'
6" @ 2774'
264 shots 2662-2729
14000 acid

10/26 258 whots 2516-2618
Acid 28,000

11/1 "
11/9 "
11/16 "
11/23 "
11/30 TD 2660'
6" @ 2774'
Perf 42000 acid
12,700,000 Gas
405# R Pr.
Comp

COMPLETED

Map No. _____ Sec. 5 Twp. 27 R. 35W

Well No. 1 C. Dew "B"

Magnolia Company

Barnett Drlg. Contractor

NW SE

FIRST REPORT
SECTION PLAT

330 Ft. from N. Line

_____ Ft. from S. Line

_____ Ft. from E. Line

330 Ft. from W. Line

		o	

Grant County

Location _____

Rig up _____

Drilling and Remarks:

10" @ 812

drlg. 2850

RECORD

Cased _____ in., _____ ft.

Sand _____

Gas _____

Oil _____

Total Depth _____

PRODUCTION

1st 24 hrs. Nat. _____

1st 24 hrs. after shot _____

Gas _____ Cu. Ft.

Dry Hole _____

Abandoned _____

Date

OCT 12 1949 19

S. J. LEWIS

Scout

Kansas

Hugoton Pool

Map No. _____ Sec. 5 Twp. 27 R. 35W

Well No. 1 C. Dew "B"

Magnolia Company

COMPLETE

Contractor

NW SE

E1,3054
SECTION PLAT

330 Ft. from N. Line

_____ Ft. from S. Line

_____ Ft. from E. Line

330 Ft. from W. Line

		o	

Grant County

Location _____

Rig up _____

Drilling and Remarks:

6" @ 2774

Prof.

45000 @ acid

12,700,000 Gas

405# R.P.

RECORD

Cased _____ in., _____ ft.

Sand _____

Gas _____

Oil _____

Total Depth 2660

PRODUCTION

1st 24 hrs. Nat. _____

1st 24 hrs. after shot _____

Gas _____ Cu. Ft.

Dry Hole _____

Abandoned _____

Date

NOV 30 1949 19

S. J. LEWIS

Scout