

KANSAS

FORM 51 10M 12-46 PETROL


Pratt county

Section 5 Township 27 Range 13-W

Well No. #1, Phillip

Company Great Western Oil Co.

NORTH

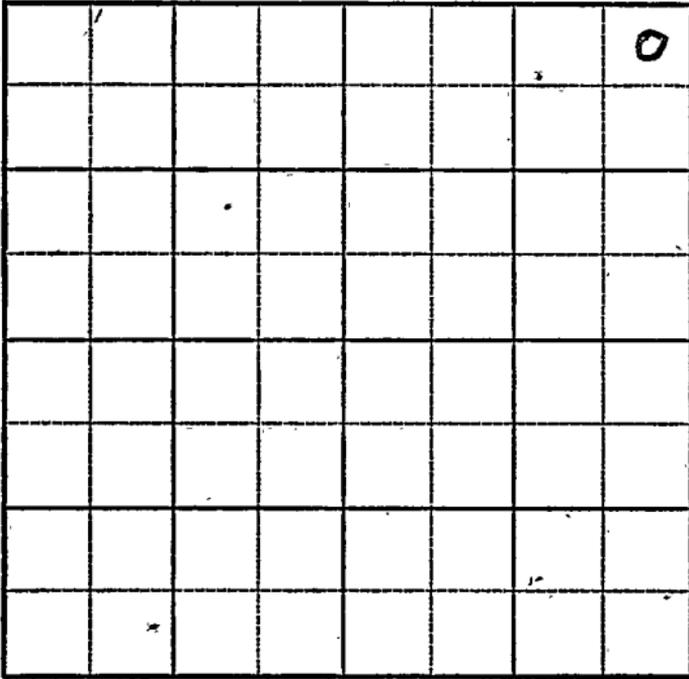

WEST

EAST

SOUTH

KANSAS

Pratt

Sec. 5 Twp. 27 R. 13-W

Well No. #1, Phillip Farm


Great Western Oil Company Company
Chance Pool

330' Ft. from N. Line

_____ Ft. from S. Line

330' Ft. from E. Line

_____ Ft. from W. Line

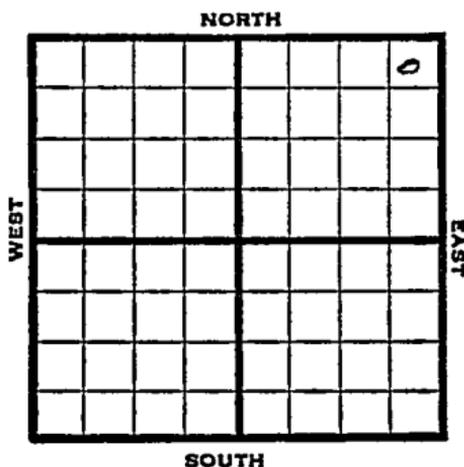

NE/C

1947 REPORT

1/22 Location

1/30 "

2/5 "

2/12 "

2/19 "

2/26 Location

ABANDONED


Kansas
KANSASMap No. 92 Sec. 5 Twp. 27 R. 13WWell No. 1 PhillipGreat Western Oil

Company

FIRST REPORT

Contractor

NE/C

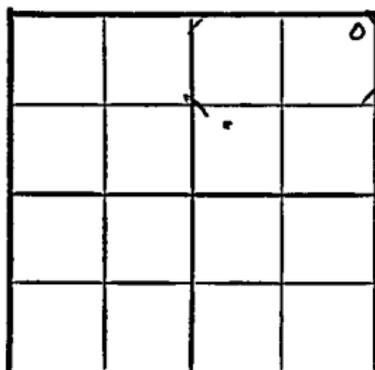SECTION PLAT330 Ft. from N. Line

_____ Ft. from S. Line

330 Ft. from E. Line

_____ Ft. from W. Line

Pratt County

Location X

Rig up _____

Drilling and Remarks:

RECORD

Cased _____ in., _____ ft.

Sand _____

Gas _____

Oil _____

Total Depth _____

PRODUCTION

1st 24 hrs. Nat. _____

1st 24 hrs. after shot _____

Gas _____

Cu. Ft.

Dry Hole _____

Abandoned _____

Date

JAN 22 1947 19S. J. LEWIS

Scout

~~misc. Small Maps~~
~~Cards *Sarah*~~
~~Tracing *MB*~~
~~France Map *✓*~~
~~Scarborough Map *✓*~~
~~Pierce Map *✓*~~
Ecological Dept.
Pierce Plat Book.

Map No. 92 Sec. 5 Twp. 27 R. 13W

Well No. 1 Phillips

Great Western Oil Company

ABANDONED

Contractor

NE/C

SECTION PLAT

330 Ft. from N. Line

_____ Ft. from S. Line

330 Ft. from E. Line

_____ Ft. from W. Line

| | | | |
|--|--|--|---|
| | | | 8 |
| | | | |
| | | | |
| | | | |

Pratt County

Location ✓

Rig up _____

Drilling and Remarks:

RECORD

Cased _____ in., _____ ft.

Sand _____

Gas _____

Oil _____

Total Depth _____

PRODUCTION

1st 24 hrs. Nat. _____

1st 24 hrs. after shot _____

Gas _____ Cu. Ft.

Dry Hole _____

Abandoned _____

Date

FEB 26 1947 19

S. I. LEWIS Scout



- Misc. Small Maps ~~✓~~
- Cards ~~✓~~
- Tracing ~~✓~~
- France Map ~~✓~~
- Scarborough Map ~~✓~~
- Pierce Map ~~✓~~
- Geological Dept. ~~✓~~
- Pierce First Book ~~✓~~