


Section 5 Township 27 Range 13W

Well No. #1 Phillips

Company Rine Dr/g.
~~Max Cohen~~

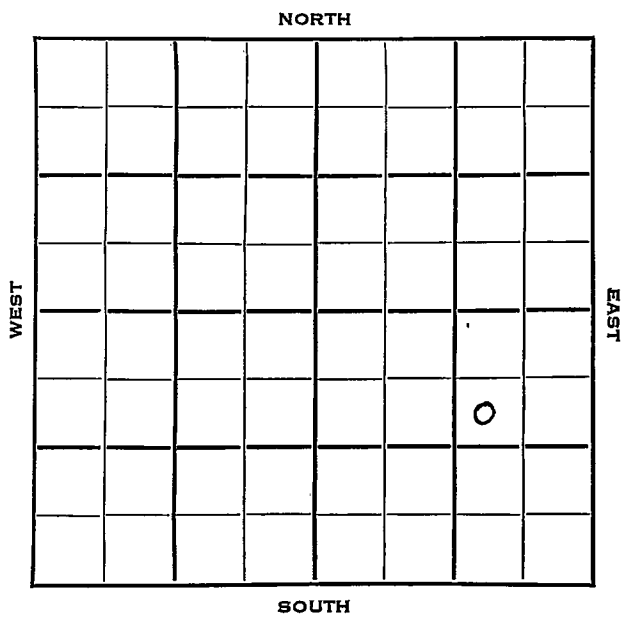

Pratt

KANSAS ✓

Sec. 5 Twp. 27 R. 13W

Well No. #1 Phillips "B" Farm

Rine Drlg.
Max Cohen Company

Armer Contractor
Chance Pool


990 Ft. from N. Line

 Ft. from S. Line

990 Ft. from E. Line

 Ft. from W. Line

SW NE SE

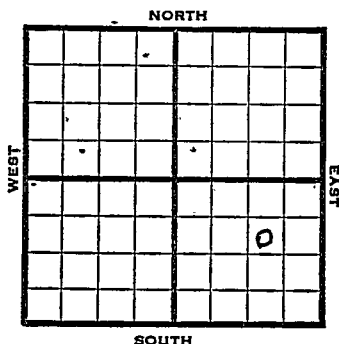

1953

Elev. 1963' REPORT

4/29

Spud 4-27-53

5/7

8" @ 897

Drilg. 3110'

5/20

Spud 4-27-53

D & A

TD 4511'

8" @ 897'

Top. 3277, Heeb 3647, Br. Lime 3790,
Laps 3808,

DS 3830-55 opn 1 hr, rec 30' gcm, 150'
so & gcm, 240' gassy oil, 390' gco
180' wtr.

997#

DST 3894-3928 opn 1 hr, rec 55' vsocm
890# Miss 4234'

DST 4239-63 opn 1 hr, rec 65' mud 740#
Kh. 4264, Viola 4314, Simp 4370,

DST 4329-73 opn 1½ hr, rec 315' wtr.
1392# Arb 4479

TD 4511'

D & A.

ABANDONED

OVER

1955
6/8

O.W.W.O.

5" @ 4487 CO to TD FU 1800' wtr.
PB 4442' Perf/4376-82 B/7 GWPB
PB 48/4334-54 B/2 BWPB PB 4325
74/4282-4300 B/6 GWPB 4 GW 500 A
PB 4271 100/4238-60 B/9 to 10 GWPB
600 A PB 4226 31/4198-4202 GSO
1½ bbl. muddy oil PH 500 A
Comp. 4 to 5 BOPD

Tp. 3277'. H. 3647'; BL 3790';
L. 3808'. C. 4234' Marm 4137
K. 4264'. V. 4314' S. 4370'
A. 4479'. TD 4515'

FIRST REPORT
COMPLETED

MAY 1 1953

Scout Cards	_____
Land Small Map	_____
Land Wall Map	_____
Tracings	_____
France Map	_____
Pierre Map	_____
Misc.	_____


Orig. Date

County Pratt State Kansas
 Sec. 5 (Blk. 27 (Sur. 13W Map No.)
 (Twp.) (Rge.)

Operator Max Cohen

Well No. 1 Farm Phillips

Elev. 1963 Location SW NE SE

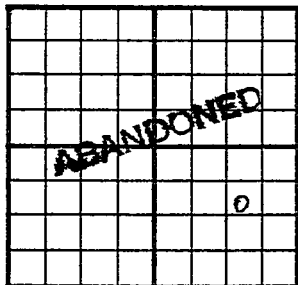

990 Ft. From N Line SE

990 Ft. From E Line Quarter

1st. Report

Completion MAY 20 1953

Remarks Chance Pool

Armer - Contr.

Spudding Date 4-27-53

Drlg. Data D & A TD 4511

8" @ 897 Top. 3277 Heeb. 3647

Br. lime 3790 Lans. 3808 DST 3830-55

open 1 hr. Rec. 30' gcm 150' so & gcm

240' gassy oil 390' gco 180' wtr.

997# DST 3894-3928 open 1 hr. Rec.

55' vsocm 890# Miss. 4234

DST 4239-63 open 1 hr. Rec. 65' mud

740# Kh. 4264 Viola 4314 Simp. 4370

DST 4329-73 open 1 1/2 hr. Rec. 315' wtr.

1392# Arb. 4479 TD 4511

D & A

J. G. McGEHEE

MAY 26 1953

Scout Cards
Land Small Map
Land Wall Map
Tracings
France Map
Pierce Map
Misc

Orig. Data

O.W.W.O.

FORM 513 REV. SUNRAY

OWWO

County Pratt Elev. 1966 KB
 Sec. 5 Twp. 27 Rge. 13W
 Company Rine Drlg. (was Max Cohen)
 Farm Name Phillips "B" No. 1

TOPS	DEPTH	LOG	DATUM	Loc. in Sec.
Anh.				SW NE SE
Tr.	3277			
Dg.	3647			
BL.				
L.	3790			
K.C.	3808			Geol.
B.K.C.				Contr.
Ce.				
C.				
M arm	4234			Pool
M.	4137			O.W.W.O.
K.	4264			
Mz.				
Mq.				
V.	4314			
S.	4370			
S.				
A.	4479			
R.				
Pe.				
G.				
TD.	4515			

FIRST REPORT
COMPLETE
JUN 8 1965

Date Comm. 5" @ 4487 CO to TD FU 1800' wtr.

PB 4442 perf/ 4376-82 B/ 7 guph PB

48/ 4334-54 B/ 2 bwph PB 4325

74/ 4282-4300 B/ 6 goph 4 gw 500 A

PB 4271 100/ 4238-60 B/ 9 to 10 gph

600 A PB 4226 31/ 4198-4202 GSO

1½ bbl. muddy oil ph 500 A

Comp. 4 to 5 bopd

Scout Cards	<i>mm</i>
Land Small Map	
Land Wall Map	
Tracings	
Fa. Ice Map	
Pierce Map	
Misc.	

JUN 27 1955