

KANSAS


FORM 51 5M 10-41 PETROL

Pratt

Section 5 Township 27 Range 12-W

Well No. #1 Brown

Company Hollow Drilling
Iuka Pool

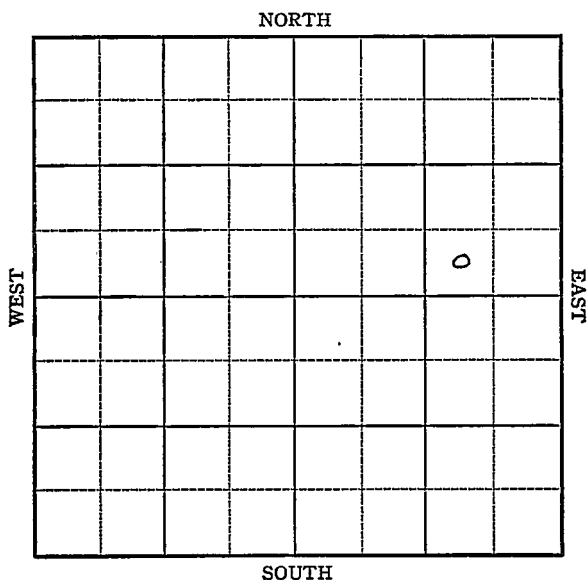


Sec. 5 Twp. 27 R. 12-WWell No. #1 Brown FarmHollow Drilling Company

(Iuka Pool)

 Ft. from N. Line330 Ft. from S. Line990 Ft. from E. Line Ft. from W. Line

Elev. 1860

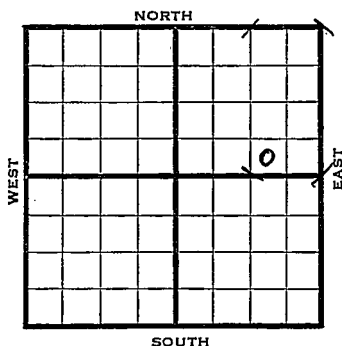

1942

REPORT

8/5	Location
8/12	"
8/19	"
8/27	"
9/2	"
9/9	"
9/16	"
9/23	"
9/30	MIM
10/7	8" - 464 WOG
10/14	Lans. 3690 Drlg. 3770
10/21	MISS 4131 VIOLA 4258 SIMP SD 4333 - 37 TD SSO
10/28	Arb. 4396 No shows T.D. 4426

ABANDONED

KANSAS

Pratt

Map No. 54 Sec. 5 Twp. 27 R. 12WWell No. 1 BrownHollow Drilling


Company

FIRST REPORT

Contractor

SW SE NE

SECTION PLAT

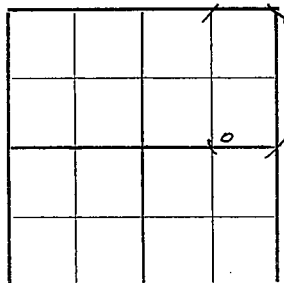 Ft. from N. Line330 Ft. from S. Line990 Ft. from E. Line Ft. from W. Line

IUKA POOL

Location XXRig up

Drilling and Remarks:

RECORD

Cased in., ft.Sand Gas Oil Total Depth

PRODUCTION

1st 24 hrs. Nat. 1st 24 hrs. after shot Gas Cu. Ft.Dry Hole Abandoned

Date

AUG 5 194219S. J. LEWIS

Scout

KANSAS

Map No. 54 Sec. 5 Twp. 27 R. 12WWell No. 1 BrownHollow Drilling CompanyABANDONED Contractor

SW SE NE

 Ft. from N. Line330 Ft. from S. Line990 Ft. from E. Line Ft. from W. Line

SECTION PLAT

			6

IUKA POOL

Location Rig up

Drilling and Remarks:

Cor 84396
Noshowe.

RECORD

Cased in., ft.Sand Gas Oil Total Depth 4426

PRODUCTION

1st 24 hrs. Nat. 1st 24 hrs. after shot Gas Cu. Ft.Dry Hole Abandoned

Date

OCT 28 1942 19

S. J. LEWIS Scout