


Section 5 Township 27 Range 12W

Well No. #1 Hoener

Company Skelly Oil

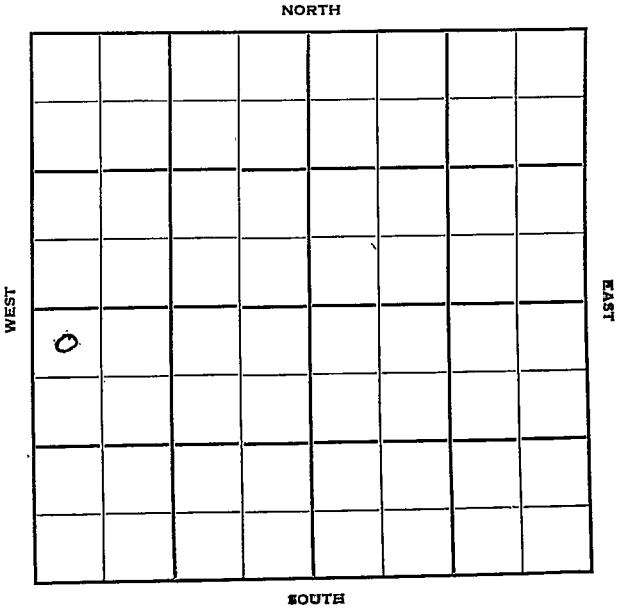

\*




Sec. 5 Twp. 27 R. 12 W

Well No. # 1 Hoener Farm

Skelly Oil Company

Contractor

330 Ft. from N. Line  
 \_\_\_\_\_ Ft. from S. Line  
 \_\_\_\_\_ Ft. from E. Line  
330 Ft. from W. Line

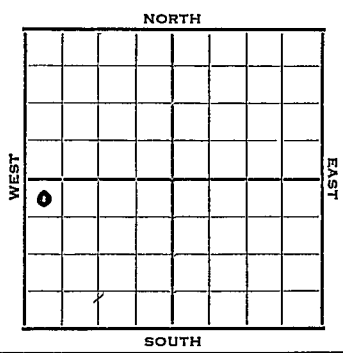

NW NW SW

1952	Elev. 1880'	REPORT
11/5		Spud 11-2-52 8" @ 452 WOC
11/12		Drlg. 2790'
11/20		Br li 3667' Lans. 3680' Miss 4112' V 4146' DST 4146-83, 1 hr, 65' GCM 1160# Simp sha 4197' Simp Dolo 4210' Drlg. 4220'
11/27		Simp sd 4224, Arb 4295 RTD 4300 5" @ 4299
12/4		PB 4275, DD 4304 wtr. 16/4252-56, 1/2 goph
12/11		Testing
12/18		Testing
12/25		Testing
12/30		Spud 11-2-52 D & A - TD 4304' 8" @ 452 Br. lime 3667' Lans. 3680' Miss. 4112' Viola 4146' DST 4146-83 open 1 hr. rec 65' GCM 1160# Simp. sh. 4197' Simp. dol. 4210' Simp sd. 4224' Arb. 4295' TD 4300' 5" @ 4299 DD 4304 wtr. PB 4275' 16/4252-56 1/2 GOPH D-hydro B/12 GWPH PB 4242 95/4222-38

OVER

1952

12/30 (Information continued)

D-hydro. S/5 BO 35 BWPD PB 4190'

120/4143-83 1500 A S/1 $\frac{1}{2}$  BWPH

PB 3922 71/3886-98 500 A S/2 BO

28 BW 9 hr. 30/3844-49 500 A

S/2 BO 40 BW 15 hr. PB 3820

48/3796-3808 S/17 BW 11 hr. PB 3790

23/3782-86 500 A FU 2300' SW

D & A

**ABANDONED**



Page

32

NOV 7 1952

Scout Cards	<i>W.M.</i>
Land Use Map	
Map	<i>B</i>

Orig. Data

County Pratt State Kansas

Sec. 5 (Blk. Twp.) 27 (Sur. Rge.) 12W Map No.

Operator Skelly Oil

Well No. 1 Farm Hoener

Elev. 1880 Location NW NW SW

o					

330 Ft. From N Line SW

330 Ft. From W Line Quarter

1st. Report

Completion DEC 30 1952

Remarks

Spudding Date 11-2-52

Drlg. Data D &amp; A TD 4304

8" @ 452 Br. line 3667 Lans. 3680

Miss. 4112 Viola 4146 DST 4146-83

open 1 hr. Rec. 65' gcm 1160#

Simp. sh. 4197 Simp. dol. 4210

Simp. sd. 4224 Arb. 4295 TD 4300

5" @ 4299 DD 4304 wtr. PB 4275

16/ 4252-56  $\frac{1}{2}$  goph D-hydro.

B/ 12 gwph PB 4242 95/ 4222-38

D-hydro. S/ 5 bo. 35 bwpd PB 4190

120/ 4143-83 1500 A S/  $1\frac{1}{2}$  bwph

PB 3922 71/ 3886-98 500 A S/ 2 bo

28 bw 9 hr. 30/ 3844-49 500 A

S/ 2 bo 40 bw 15 hr PB 3820 48/ 3796-

3808 S/ 17 bw 11 hr. PB 3790

J. G. MCGEEFF

Scout Cards	500 A
Land Small Map	
Land Wall Map	
Tracings	
France Map	
Pierce Map	
Misc.	

JAN 13 1952

23 / 3782-86

Orig. Date