


Section 5 Township 27 Range 2W

Well No. #1 Strunk

Company E. Adair & Lee Phillips

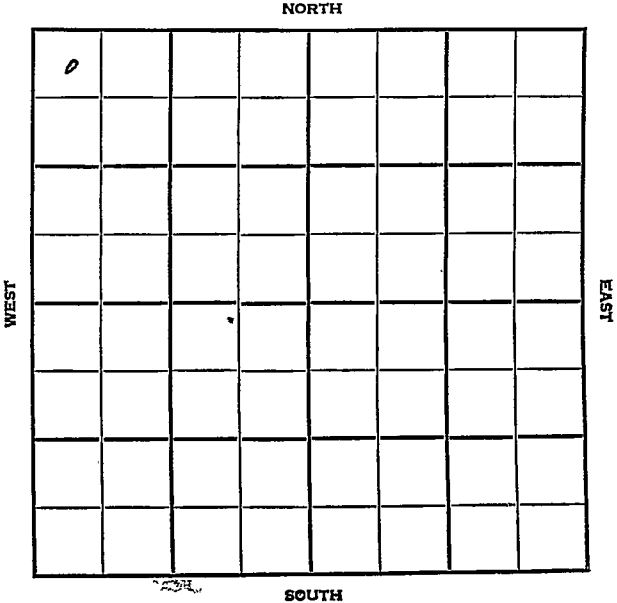

Sedgwick KANSAS


SEC.	TWP.	R.
5	27	2W
WELL NO.		
1 Strunk		FARM
COMPANY		
E. Adair & Lee Phillips		
CONTRACTOR		

330 Ft. from N. Line

Ft. from S. Line

Ft. from E. Line

330 Ft. from W. Line

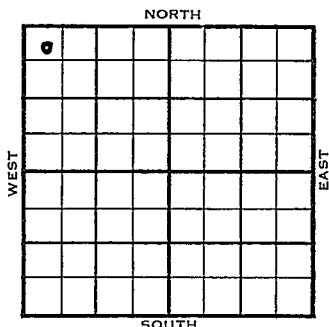

NW NW NW

Sun - DHM

	ELEVATION	REPORT
1955	1454'	

1/5
1/26

C&P
 Spud 1-7-55
 D & A
 TD 4220'
 8" @ 191'
 Top 2069' Br. Lime 2668' Lans 2705'
 KC 2961' Doug 2523'
 DST 3118'-25' opn 1 hr, rec 810' s.w.
 Miss 3680' Kh. 3992' Misener 4073'
 Viola 4081' Simp 4105' Arb. 4193'
 TD 4220'
 LogTops: Br. Lime 2680' Lans 2704'
 KC 2959' Miss 3575' Kh. 3992' Misner
 4074' Viola 4080' Simp 4105' Arb. 4194'
 D & A

ABANDONED

County Sedgwick State KansasSec. 5 (Blk.) 27 (Sur.) 2W Map No.Operator E. Adair & Lee PhillipsWell No. 1 Farm StrunkElev. Location NW NW NW

0							

330 Ft. From N Line NW330 Ft. From W Line Quarter1st. Report IAN 5 1955

Completion


Remarks Sun - DHM

Spudding Date

Drlg. Data

Cellar & pits

FABEN GILSTRAP

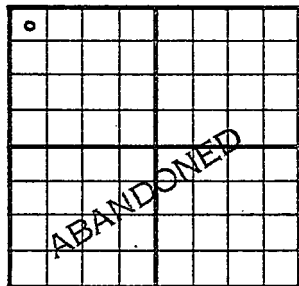County Sedgwick State KansasSec. 5 (Blk.) 27 (Sur.) 2W Map No.Operator E. Adair & Lee PhillipsWell No. 1 Farm StrunkElev. 1454 Location NW NW NW330 Ft. From N Line NW330 Ft. From W Line Quarter

1st. Report

Completion JAN 26 1955

Remarks

Adair - Contr.Spudding Date 1-7-55Drlg. Data D & A TD 42208" @ 191 Top. 2069 Br. lime 2668Lans. 2705 KC 2961 Doug. 2523DST 3118-25 open 1 hr. Rec. 810' swMiss. 3680 Kh. 3992 Misener 4073Viola 4080 Simp. 4105 Arb. 4193TD 4220 LOG TOPS:Br. lime 2680 Lans. 2704 KC 2959Miss. 3575 Kh. 3992 Misener 4074Viola 4080 Simp. 4105 Arb. 4194D & A

FABEN GILSTRAP