


Section 6 Township 27 Range 35N

Well No. 1 Bolenbaugh unit

Company Magnolia

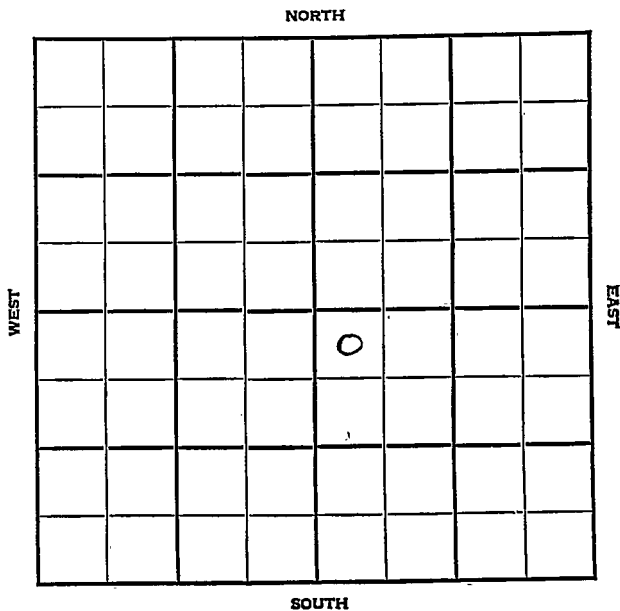

Sec. 6 Twp. 27 R. 35W

Well No. #1 Bolenbaugh Unit Farm


Magnolia Company
Hugoton

330 Ft. from N. Line

_____ Ft. from S. Line

_____ Ft. from E. Line

330 Ft. from W. Line

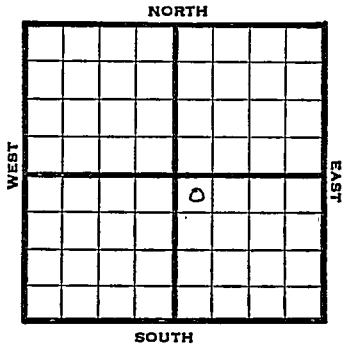

NW SE

1948	E ₁ 3066' REPORT
4/28	Location
5/5	10" @ 797' WO
5/12	TD 2801' 7" @ 2800'
5/19	"
5/26	144 shots 2702-32' - 7000 acid 72 shots 2665-83' - 7000 acid 72 shots 2610-26'
6/1	7000 acid 72 shots 2566-84' - 7000 acid.
6/9	48 shots 2550-62 7000 acid
6/16	"
6/23	TD 2801' 7" @ 2800' Perf 35000 acid 13,200,000 gas. 370# R pr. Comp.
COMPLETED	

Map No. _____ Sec. 6 Twp. 27 R. 35WWell No. 1 Bolenbaugh UnitMagnolia Company~~FIRST REPORT~~ Contractor

NW SE

SECTION PLAT

330 Ft. from N. Line

_____ Ft. from S. Line

_____ Ft. from E. Line

330 Ft. from W. Line

		o	

Grant County

Location X

Rig up _____

Drilling and Remarks:

RECORD

Cased _____ in., _____ ft.

Sand _____

Gas _____

Oil _____

Total Depth _____

PRODUCTION

1st 24 hrs. Nat. _____

1st 24 hrs. after shot _____

Gas _____ Cu. Ft.

Dry Hole _____

Abandoned _____

Date

APR 28 1948 19 _____ S. I. LEWIS Scout

Map No. _____ Sec. 6 Twp. 27 R. 35W

Well No. 1 Bolenbaugh Unit

Magnolia _____ Company

COMPLETE

Contractor

NW SE

E13066
SECTION PLAT

330 Ft. from N. Line

_____ Ft. from S. Line

_____ Ft. from E. Line

330 Ft. from W. Line

		a	

Grant County

Location _____

Rig up _____

Drilling and Remarks:

7" @ 2500

Perf.

35000 acid

13,200,000 Gas

270 # RP

RECORD

Cased _____ in., _____ ft.

Sand _____

Gas _____

Oil _____

Total Depth 2801

PRODUCTION

1st 24 hrs. Nat. _____

1st 24 hrs. after shot _____

Gas _____ Cu. Ft.

Dry Hole _____

Abandoned _____

Date

JUN 23 1948 19

S. J. LEWIS Scout