


Section 6 Township 27 Range 39W

Well No. 1 Bucklin

Company Stanolind Oil and Gas Company

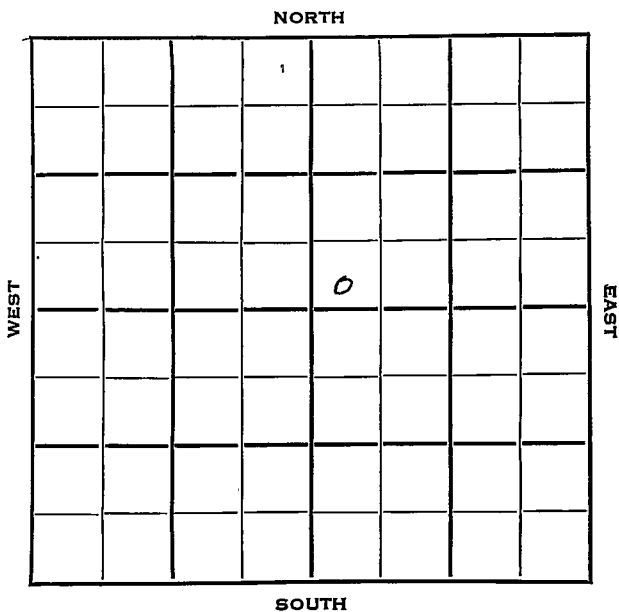

Stanton

SAS ✓

Sec. 26 Twp. 27 R. 39W

Well No. #1 Pucklin Farm

Stanolind Oil and Gas Company Company

Contractor


Ft. from N. Line

150 Ft. from S. Line

Ft. from E. Line

150 Ft. from W. Line

SW NE

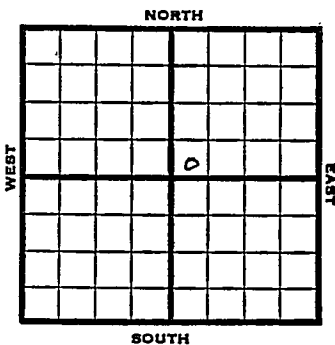

1953 Elev. 3289' REPORT

3/4 Location
 3/12 "
 3/19 8" @ 646'
 3/26 RTD 2565 5" @ 2541
 4/2 NR
 4/8 Spud 3-14-53
 Gas well
 TD 2565
 8" @ 646
 TD 2565
 5" @ 2541
 CO to 2565, 2500A
 48/2370-78, 84/2380-94, 24/2400-04,
 30/2417-22, 60/2424-35, 24/2438-42,
 24/2450-54, 30/2457-62, 24/2490-94,
 144/2498-2522, 32500A
 Her 2370, Win 2417, Tow 2490
 Comp 9,749,000 gas

COMPLETED:

